


1 LOCATION OF WATER WELL:		Fraction	Section Number	Township Number	Range Number
County:	Barton	SW ¼ NE ¼ NW ¼	9	T 20 S	R 11W E/W

Distance and direction from nearest town or city street address of well if located within city?

E. 1/2, 1 1/2 S of Ellinwood, Kansas

2] WATER WELL OWNER:	Kenny Peters	H 30 Drilling	Peters No. 5
RR#, St. Address, Box # :	Ellinwood, Ks.	251 N. Water	Board of Agriculture, Division of Water Resources
City, State, ZIP Code :	67526	Wichita, Ks. 67202	Application Number: Unknown

3 LOCATE WELL'S LOCATION WITH AN "X" IN SECTION BOX: 4 DEPTH OF COMPLETED WELL: 45 ft. ELEVATION: Unknown

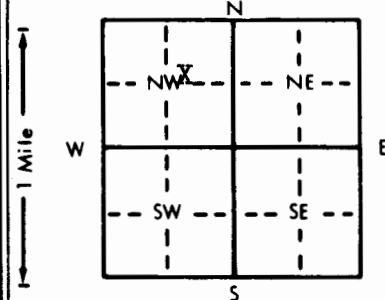

4 DEPTH OF COMPLETED WELL..... 45 ft. ELEVATION: Unknown

Depth(s) Groundwater Encountered 1. 10 ft. 2. ft. 3. ft.
WELL'S STATIC WATER LEVEL 10 ft. below land surface measured on mo/day/yr 7/14/84

Pump test data:	Well water was	 ft. after	 hours pumping	 gpm
Est. Yield ... 60 ... gpm:	Well water was	 ft. after	 hours pumping	 gpm

Bore Hole Diameter . . . 8 . . . in. to 45 . . . ft., and . . . in. to . . . ft.

WELL WATER TO BE USED AS:		5 Public water supply	8 Air conditioning	11 Injection well
1 Domestic	3 Feedlot	6 <u>Oil field water supply</u>	9 Dewatering	12 Other (Specify below)
2 Irrigation	4 Industrial	7 Lawn and garden only	10 Observation well	

Was a chemical/bacteriological sample submitted to Department? Yes.....No.....; If yes, mo/day/yr sample was submitted
 Water Well Disinfected? Yes _____ No _____

5	TYPE OF BLANK CASING USED:		5 Wrought iron	8 Concrete tile	CASING JOINTS: <u>Glued</u> Clamped Welded Threaded
	1 Steel	3 RMP (SR)	6 Asbestos-Cement	9 Other (specify below)	
	2 PVC	4 ABS	7 Fiberglass		

Blank casing diameter 5 . . . in. to . . . 25 . . . ft., Dia . . . in. to ft., Dia . . . in. to ft.
Casing height above land surface 12 in., weight 2.8 . . . lbs./ft. Wall thickness or gauge No. Sh. 40

TYPE OF SCREEN OR PERFORATION MATERIAL:			7 <u>PVC</u>	10 Asbestos-cement
1 Steel	3 Stainless steel	5 Fiberglass	8 RMP (SR)	11 Other (specify)
2 Brass	4 Galvanized steel	6 Concrete tile	9 ABS	12 None used (open hole)

SCREEN OR PERFORATION OPENINGS ARE:		5 Gauzed wrapped	<u>8 Saw cut</u>	11 None (open hole)
1 Continuous slot	3 Mill slot	6 Wire wrapped	9 Drilled holes	
2 Louvered shutter	4 Key punched	7 Torch cut	10 Other (specify)	

SCREEN-PERFORATED INTERVALS:	From 25	ft. to 45	ft. From	ft. to	ft.
	From	ft. to	ft. From	ft. to	ft.
GRAVEL PACK INTERVALS:	From 10	ft. to 45	ft. From	ft. to	ft.
	From	ft. to	ft. From	ft. to	ft.

6 GROUT MATERIAL: 1 Neat cement 2 Cement grout 3 Bentonite 4 Other
Grout Intervals: From 0 ft. to 10 ft. From ft. to ft. From ft. to ft.

What is the nearest source of possible contamination:						10 Livestock pens	14 Abandoned water well
1 Septic tank	4 Lateral lines	7 Pit privy	11 Fuel storage	15 <u>Oil well/Gas well</u>			
2 Sewer lines	5 Cess pool	8 Sewage lagoon	12 Fertilizer storage	16 Other (specify below)			
3 Watertight sewer lines	6 Seepage pit	9 Feedyard	13 Insecticide storage				

Direction from well? South How many feet? 60

[illegible]

7 CONTRACTOR'S OR LANDOWNER'S CERTIFICATION: This water well was (1) constructed, (2) reconstructed, or (3) plugged under my jurisdiction and was completed on (mo/day/year) 7/14/84 and this record is true to the best of my knowledge and belief. Kansas

Water Well Contractor's License No. 186 This Water Well Record was completed on (mo/day/yr) 8/30/84
under the business name of Kellys Water Well Service by (signature) [Signature]

INSTRUCTIONS: Use typewriter or ball point pen, PLEASE PRESS FIRMLY and PRINT clearly. Please fill in blanks, underline or circle the correct answers. Send top three copies to Kansas Department of Health and Environment, Division of Environment, Environmental Geology Section, Topeka, KS 66620. Send one to WATER WELL OWNER and retain one for your records.