USE TYPEWRITER OR BALL POINT PEN-PRESS FIRMLY, PRINT CLEARLY.

WATER WELL RECORD
KSA 82a-1201-1215

Kansas Department of Health and Environment-Division of Environment
(Water well Contractors)
Topeka, Kansas 66620

| 1. Location of well: | County | Fraction | Section number | Township number | Range number |
|---|---|---|---|---|---|
| | Barton | C 1/4 NW 1/4 NW 1/4 | 25 | T 20 S | R 11 E (W) |

2. Distance and direction from nearest town or city: 4 mi S. 5 mi E. South side of rd. from Ellinwood, Ks
Street address of well location if in city:

3. Owner of well: B & N Drilling
R.R. or street: municipal airport
City, state, zip code: Independence, Ks. 67301

4. Locate with "X" in section below:

Sketch map:

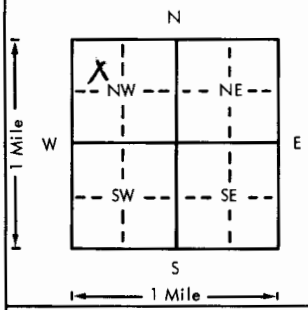


6. Bore hole dia. 11 in. Completion date
Well depth 60 ft. 9-6-77

7. __ Cable tool X Rotary __ Driven __ Dug
__ Hollow rod __ Jetted __ Bored __ Reverse rotary

8. Use: __ Domestic __ Public supply X Industry
__ Irrigation __ Air conditioning __ Stock
__ Lawn __ Oil field water __ Other

9. Casing: Material PVC Height: Above or ~~below~~
Threaded ___ Welded ___ Surface 18 in.
RMP ___ PVC PVC Weight ___ lbs./ft.
Dia. 7 in. to 60 ft. depth Wall Thickness: inches or
Dia. ___ in. to ___ ft. depth gage No. 237

| 5. Type and color of material | From | To |
|---|---|---|
| Sandy top soil | 0 | 3 |
| Fine sand | 3 | 6 |
| Gray clay & fine sand | 6 | 7 |
| Sand & gravel | 7 | 34 |
| Yellow clay | 34 | 36 |
| Sand & gravel | 36 | 39 |
| White clay | 39 | 43 |
| Sand & gravel | 43 | 60 |

(Use a second sheet if needed)

10. Screen: Manufacturer's name CertainTeed
Type PVC Dia.
Slot/~~gauze~~ 116 Length 20
Set between 40 ft. and 60 ft.
ft. and ft.
Gravel pack? X Size range of material 1/2 3/4 3/8

11. Static water level: mo./day/yr.
13 ft. below land surface Date 9-6-77

12. Pumping level below land surfaces:
ft. after hrs. pumping N/A g.p.m.
ft. after hrs. pumping g.p.m.
Estimated maximum yield g.p.m.

13. Water sample submitted: mo./day/yr.
__ Yes ✓ No Date

14. Well head completion:
__ Pitless adapter ___ Inches above grade

15. Well grouted? X
With: X Neat cement __ Bentonite __ Concrete
Depth: From 0 ft. to 10 ft.

16. Nearest source of possible contamination:
ft. 75 Direction SE Type oil well
Well disinfected upon completion? __ Yes ✓ No

17. Pump: X Not installed
Manufacturer's name
Model number HP Volts
Length of drop pipe ft. capacity g.p.m.
Type:
__ Submersible __ Turbine
__ Jet __ Reciprocating
__ Centrifugal __ Other

18. Elevation:

Topography:
__ Hill
__ Slope
✓ Upland
__ Valley

19. Remarks:

1752

20. Water well contractor's certification:
This well was drilled under my jurisdiction and this report is true to the best of my knowledge and belief.
Business name Rosencrants Bennis License No. 134
Address Great Bend Ks 67530
Signed Sandy K. Geare Date 9-14-77
Authorized representative

T 20 R 11 (W) Sec 25 1/4 C NW 1/4 NW 1/4

Forward the white, blue and pink copies to the Department of Health and Environment

Form WWC-5

MI-1023