

1	LOCATION OF WATER WELL:	Fraction	Section Number	Township Number	Range Number
County:	Barton	NE ¼ NE ¼ NE ¼	30	T 20 S	R 11W E/W

Distance and direction from nearest town or city street address of well if located within city?

1S, 1/2W, 3S of Ellinwood, KS

2	WATER WELL OWNER: First Baptist Church	c/o Kerry Hendricks
---	--	---------------------


BB# St. Address Box # : 503B SE 110 Ave.

City, State, ZIP Code : Ellinwood, KS 67526

Board of Agriculture, Division of Water Resources
Application Number:

3 LOCATE WELL'S LOCATION WITH AN "X" IN SECTION BOX:

4	DEPTH OF COMPLETED WELL	106	ft. ELEVATION:	unknown
---	-------------------------------	-----	----------------------	---------

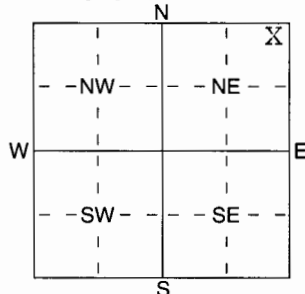

Depth(s) Groundwater Encountered 1 42 ft. 2 _____ ft. 3 _____ ft.

WELL'S STATIC WATER LEVEL 42 ft. below land surface measured on mo/day/yr 04/04/05

Pump test data: Well water was ft. after hours pumping gpm
 Est. Yield 60 gpm: Well water was ft. after hours pumping gpm

WELL WATER TO BE USED AS: 5 Public water supply 8 Air conditioning 11 Injection well

1 Domestic	3 Feedlot	6 Oil field water supply	9 Dewatering	12 Other (Specify below)
------------	-----------	--------------------------	--------------	--------------------------

2 Irrigation 4 Industrial 7 Domestic (lawn & garden) 10 Monitoring well

Was a chemical/bacteriological sample submitted to Department? Yes No; If yes, mo/day/hrs sample was submitted
Water Well Disinfected? Yes No

5	TYPE OF BLANK CASING USED:
---	----------------------------

1 Steel	3 RMP (SR)
2 <u>PVC</u>	4 ABS

ank casing diameter 5 in. to 36 ft., Dia in. to ft., Dia in. to ft.

Casing height above land surface 12 in., weight 2.8 lbs./ft. Wall thickness or gauge No. Sch. 40

TYPE OF SCREEN OR PERFORATION MATERIAL:

1 Steel	3 Stainless Steel	5 Fiberglass	8 RMP (SR)	11 Other (Specify)
2 Brass	4 Galvanized Steel	6 Concrete tile	9 ABS	12 None used (open hole)

SCREEN OR PERFORATION OPENINGS ARE:

1 Continuous slot 3 Mill slot 6 Wire wrapped 9 Drilled holes
2 Louvered shutter 4 Key punched 7 Torch cut 10 Other (specify) ft.

SCREEN-PERFORATED INTERVALS: From 86 ft. to 106 ft., From _____ ft. to _____ ft.

From ft. to ft., From ft. to ft.

From26..... ft. to79..... ft., From84..... ft. to106..... ft.

From ft. to ft., From ft. to ft.

6	GROUT MATERIAL:	1 Neat cement	2 Cement grout	3 Bentonite	4 Other
---	-----------------	---------------	----------------	-------------	---------------

Grout Intervals: From 0 ft. to 26 ft., From 79 ft. to 84 ft., From _____ ft. to _____ ft.

What is the nearest source of possible contamination:

1 Septic tank	<u>4 Lateral lines</u>	7 Pit privy	11 Fuel storage	15 Oil well/Gas well
2 Sewer lines	5 Cess pool	8 Sewage lagoon	12 Fertilizer storage	16 Other (specify below)
3 Watertight sewer lines	6 Seepage pit	9 Feedyard	13 Insecticide storage	

Direction from well? Northwest

How many feet? 150

[illegible]

7. CONTRACTOR'S OR LANDOWNER'S CERTIFICATION: This water well was (1) constructed, (2) reconstructed, or (3) plugged under my jurisdiction and was completed on (mo/day/year) 04/04/05 and this record is true to the best of my knowledge and belief. Kansas Water Well Contractor's Licence No 186 This Water Well Record was completed on (mo/day/yr) 05/02/05 under the business name of Kelly's Water Well Service, Inc. by (signature) Kathleen L. Good