WATER WELL RECORD **Form WWC-5** Division of Water Resources App. No. _____

1 LOCATION OF WATER WELL: County: Barton | Fraction: ¼ S2 ¼ NE ¼ SE ¼ | Section Number: 29 | Township No.: T 20 S | Range Number: R 11 ☐E ☑W

Street/Rural Address of Well Location; if unknown, distance & direction from nearest town or intersection: If at owner's address, check here ☐.
4 3/4 South, 3/4 East of Ellinwood

Global Positioning System (GPS) information:
Latitude: ..... (in decimal degrees)
Longitude: ..... (in decimal degrees)
Elevation: .....
Datum: ☐ WGS 84, ☐ NAD 83, ☐ NAD 27
Collection Method:
☐ GPS unit (Make/Model: .....)
☐ Digital Map/Photo, ☐ Topographic Map, ☐ Land Survey
Est. Accuracy: ☐ <3 m, ☐ 3-5 m, ☐ 5-15 m, ☐ >15 m

2 WATER WELL OWNER: Marvin Sessler
RR#, Street Address, Box #: 567 SE 120 Avenue
City, State, ZIP Code : Ellinwood, Ks. 67526

3 LOCATE WELL WITH AN "X" IN SECTION BOX:

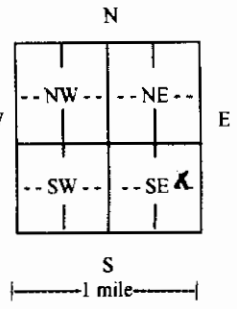

4 DEPTH OF COMPLETED WELL 60 ..... ft.
Depth(s) Groundwater Encountered (1)..... ft. (2)..... ft. (3)..... ft.
WELL'S STATIC WATER LEVEL 25 ..... ft. below land surface measured on mo/day/yr. 3-16-12 .....
Pump test data: Well water was..... ft. after..... hours pumping..... gpm
EST. YIELD N/A gpm. Well water was..... ft. after..... hours pumping..... gpm
Bore Hole Diameter 10 ..... in. to 60 ..... ft., and ..... in. to ..... ft.
WELL WATER TO BE USED AS: ☐ Public water supply ☐ Geothermal ☐ Injection well
☐ Domestic ☐ Feedlot ☐ Oil field water supply ☐ Dewatering ☑ Other (Specify below)
☐ Irrigation ☐ Industrial ☐ Domestic-lawn & garden ☐ Monitoring well Stock .....
Was a chemical/bacteriological sample submitted to Department? ☐ Yes ☑ No
If yes, mo/day/yr sample was submitted.....
Water well disinfected? ☑ Yes ☐ No

5 TYPE OF CASING USED: ☐ Steel ☑ PVC ☐ Other .....
CASING JOINTS: ☑ Glued ☐ Clamped ☐ Welded ☐ Threaded
Casing diameter 5 ..... in. to 60 ..... ft., Diameter ..... in. to ..... ft., Diameter ..... in. to ..... ft.
Casing height above land surface 18 ..... in., Weight SDR-26 ..... lbs./ft., Wall thickness or gauge No. .....
TYPE OF SCREEN OR PERFORATION MATERIAL:
☐ Steel ☐ Stainless Steel ☑ PVC ☐ Other (Specify) .....
☐ Brass ☐ Galvanized Steel ☐ None used (open hole)
SCREEN OR PERFORATION OPENINGS ARE:
☐ Continuous slot ☐ Mill slot ☐ Gauze wrapped ☐ Torch cut ☐ Drilled holes ☐ None (open hole)
☐ Louvered shutter ☐ Key punched ☐ Wire wrapped ☑ Saw cut ☐ Other (specify) .....
SCREEN-PERFORATED INTERVALS: From 60 ..... ft. to 40 ..... ft., From ..... ft. to ..... ft.
From ..... ft. to ..... ft., From ..... ft. to ..... ft.
GRAVEL PACK INTERVALS: From 60 ..... ft. to 20 ..... ft., From ..... ft. to ..... ft.
From ..... ft. to ..... ft., From ..... ft. to ..... ft.

6 GROUT MATERIAL: ☐ Neat cement ☐ Cement grout ☑ Bentonite ☐ Other .....
Grout Intervals: From ..... ft. to ..... ft., From 20 ..... ft. to 0 ..... ft., From ..... ft. to ..... ft.
What is the nearest source of possible contamination:
☐ Septic tank ☐ Lateral lines ☐ Pit privy ☐ Livestock pens ☐ Insecticide storage ☑ Other (specify below)
☐ Sewer lines ☐ Cesspool ☐ Sewage lagoon ☐ Fuel storage ☐ Abandoned water well
☐ Watertight sewer lines ☐ Seepage pit ☐ Feedyard ☐ Fertilizer storage ☐ Oil well/gas well House .....
Direction from well Southeast ..... Distance from well 150ft .....

FROM	TO	LITHOLOGIC LOG	FROM	TO	LITHO. LOG (cont.) or PLUGGING INTERVALS
0	3	Sandy top soil			
3	37	Sandy tan, brown, & gray clay			
37	54	Sand & gravel-clean, small, loose			
54	60	Gray clay			

7 CONTRACTOR'S OR LANDOWNER'S CERTIFICATION: This water well was ☑ constructed, ☐ reconstructed, or ☐ plugged under my jurisdiction and was completed on (mo/day/year) 3-16-12 ..... and this record is true to the best of my knowledge and belief. Kansas Water Well Contractor's License No. 134 ..... This Water Well Record was completed on (mo/day/year) 4-30-12 ..... under the business name of Rosencrantz-Bemis ..... by (signature) [signature] .....

INSTRUCTIONS: Use typewriter or ball point pen. *PLEASE PRESS FIRMLY* and *PRINT* clearly. Please fill in blanks and check the correct answers. Send three copies (white, blue, pink) to Kansas Department of Health and Environment, Bureau of Water, Geology Section, 1000 SW Jackson St., Suite 420, Topeka, Kansas 66612-1367. Telephone 785-296-5524. Send one copy to WATER WELL OWNER and retain one for your records. Include fee of $5.00 for each constructed well. Visit us at http://www.kdheks.gov/waterwell/index.html.

KSA 82a-1212 Check: ☒ White Copy, ☐ Blue Copy, ☐ Pink Copy