


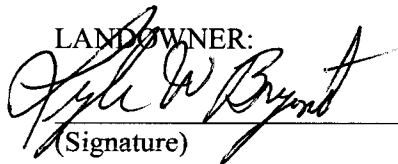

ASSIGNMENT OF WATER WELL TO LANDOWNER

I, Donna Bryant of 111 East 3rd Street
(Landowner's address)
Ellinwood, KS 67526 am the landowner on which a water well is located in
(City) (State)
the NE quarter of the SW quarter of the SE quarter in Section 23, Township 20,
Range 11 E/W, in Barton County, Kansas which is approximately
2254 feet ~~north~~/south, and 1553 feet east/~~west~~ of the apparent SE section
corner. The water well was drilled in 11/2012 (month/year).

I hereby request that L D DRilling, Inc. leave the water well,
(Operator name)
which was drilled by Temporary Water Permit # 20120914, unplugged, and I will
assume all responsibility for the plugging of said water well in accordance with the requirements
of the Kansas Department of Health and Environment regulation K.A.R. 28-30-7.


LANDOWNER:
 (Son)
(Signature) (Date)

(Print)

IF ADDITIONAL LANDOWNER

(Signature) (Date)

(Print)

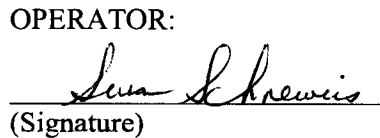OPERATOR:
 5-10-13
(Signature) (Date)

By: Susan Schneeweis
(Agent) L D Drilling, Inc.

RECEIVED

MAY 24 2013

BUREAU OF WATER

WATER WELL RECORD

Form WWC-5

Division of Water Resources App. No.

20120914

1 LOCATION OF WATER WELL: County: Barton		Fraction ¼ NE ¼ SW ¼ SE ¼	Section Number 23	Township No. T 20 S	Range Number R 11 ☐ E ☒ W
Street/Rural Address of Well Location; if unknown, distance & direction from nearest town or intersection: If at owner's address, check here ☐ 3S, 3E of Ellinwood, KS			Global Positioning System (GPS) information: Latitude: (in decimal degrees) Longitude: (in decimal degrees) Elevation: Datum: ☐ WGS 84, ☐ NAD 83, ☐ NAD 27 Collection Method: ☐ GPS unit (Make/Model:) ☐ Digital Map/Photo, ☐ Topographic Map, ☐ Land Survey Est. Accuracy: ☐ <3 m, ☐ 3-5 m, ☐ 5-15 m, ☐ >15 m		
2 WATER WELL OWNER: Donna Bryant RR#, Street Address, Box #: 111 East 3rd St. City, State, ZIP Code : Ellinwood, KS 67526					
3 LOCATE WELL WITH AN "X" IN SECTION BOX: N W E S S -----1 mile-----		4 DEPTH OF COMPLETED WELL 47 ft. Depth(s) Groundwater Encountered (1).14 ft. (2) ft. (3) ft. WELL'S STATIC WATER LEVEL 14 ft. below land surface measured on mo/day/yr. 11/12/12 Pump test data: Well water was ft. after hours pumping gpm EST. YIELD 60 gpm. Well water was ft. after hours pumping gpm Bore Hole Diameter in. to ft., and in. to ft. WELL WATER TO BE USED AS: ☐ Public water supply ☐ Geothermal ☐ Injection well ☐ Domestic ☐ Feedlot ☒ Oil field water supply ☐ Dewatering ☐ Other (Specify below) ☐ Irrigation ☐ Industrial ☐ Domestic-lawn & garden ☐ Monitoring well Was a chemical/bacteriological sample submitted to Department? ☐ Yes ☒ No If yes, mo/day/yr sample was submitted Water well disinfected? ☒ Yes ☐ No			
5 TYPE OF CASING USED: ☐ Steel ☒ PVC ☐ Other CASING JOINTS: ☒ Glued ☐ Clamped ☐ Welded ☐ Threaded Casing diameter 5 in. to 27 ft., Diameter in. to ft., Diameter in. to ft. Casing height above land surface 12 in., Weight 2.8 lbs./ft., Wall thickness or gauge No. Sch. 40 TYPE OF SCREEN OR PERFORATION MATERIAL: ☐ Steel ☐ Stainless Steel ☒ PVC ☐ Other (Specify) ☐ Brass ☐ Galvanized Steel ☐ None used (open hole) SCREEN OR PERFORATION OPENINGS ARE: ☐ Continuous slot ☐ Mill slot ☐ Gauze wrapped ☐ Torch cut ☐ Drilled holes ☐ None (open hole) ☐ Louvered shutter ☐ Key punched ☐ Wire wrapped ☒ Saw cut ☐ Other (specify) SCREEN-PERFORATED INTERVALS: From 27 ft. to 47 ft., From ft. to ft. From ft. to ft., From ft. to ft. GRAVEL PACK INTERVALS: From 23 ft. to 47 ft., From ft. to ft. From ft. to ft., From ft. to ft.					
6 GROUT MATERIAL: ☐ Neat cement ☐ Cement grout ☒ Bentonite ☐ Other Grout Intervals: From 0 ft. to 23 ft., From ft. to ft., From ft. to ft. What is the nearest source of possible contamination: ☐ Septic tank ☐ Lateral lines ☐ Pit privy ☐ Livestock pens ☐ Insecticide storage ☐ Other (specify below) ☐ Sewer lines ☐ Cesspool ☐ Sewage lagoon ☐ Fuel storage ☐ Abandoned water well ☐ Watertight sewer lines ☐ Seepage pit ☐ Feedyard ☐ Fertilizer storage ☒ Oil well/gas well Direction from well North Northeast Distance from well 950					
FROM	TO	LITHOLOGIC LOG	FROM	TO	LITHO. LOG (cont.) or PLUGGING INTERVALS
0	2	top soil			
2	5	clay			Donna Lease
5	14	sand and gravel			
14	16	clay			L. D. Drilling, Inc
16	47	sand and gravel			7 SW 26th Ave.
					Great Bend, KS 67530
7 CONTRACTOR'S OR LANDOWNER'S CERTIFICATION: This water well was ☒ constructed, ☐ reconstructed, or ☐ plugged under my jurisdiction and was completed on (mo/day/year) 11/12/12 and this record is true to the best of my knowledge and belief. Kansas Water Well Contractor's License No. 186 This Water Well Record was completed on (mo/day/year) 11/24/12 under the business name of Kelly's Water Well Service, Inc. by (signature) <i>Kelly's Water Well Service, Inc.</i>					
INSTRUCTIONS: Use typewriter or ball point pen. PLEASE PRESS FIRMLY and PRINT clearly. Please fill in blanks and check the correct answers. Send three copies (white, blue, pink) to Kansas Department of Health and Environment, Bureau of Water, Geology Section, 1000 SW Jackson St., Suite 420, Topeka, Kansas 66612-1367. Telephone 785-296-5524. Send one copy to WATER WELL OWNER and retain one for your records. Include fee of \$5.00 for each constructed well. Visit us at http://www.kdheks.gov/waterwell/index.html .					