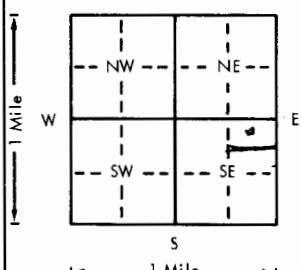


USE TYPEWRITER OR BALL
POINT PEN-PRESS FIRMLY,
PRINT CLEARLY.

WATER WELL RECORD
KSA 82a-1201-1215

Kansas Department of Health and
Environment-Division of Environment
(Water well Contractors)
Topeka, Kansas 66620

Einstein #1

1. Location of well:	County <i>Barton</i>	Fraction <i>CN 1/4 NE 1/4 SE 1/4</i>	Section number <i>1</i>	Township number <i>T 20</i>	Range number <i>S R 12 E/W</i>
2. Distance and direction from nearest town or city: <i>2 South 1 1/2 West</i>	Owner of well: <i>Dube Drilling Co</i>				
Street address of well location if in city: <i>1/2 north Ellimurk</i>	R.R. or street: <i>Great Bend Kansas</i>				
4. Locate with "X" in section below:		Sketch map:			
					
5. Type and color of material		From	To	6. Bore hole dia. <i>5</i> in. Completion date <i>9-1-75</i>	
<i>Sandy Clay</i>		<i>0</i>	<i>10</i>	Well depth <i>35</i> ft.	
<i>Sand</i>		<i>10</i>	<i>22</i>	7. ☐ Cable tool ☒ Rotary ☐ Driven ☐ Dug	
<i>Gravel</i>		<i>22</i>	<i>35</i>	☐ Hollow rod ☐ Jetted ☐ Bored ☐ Reverse rotary	
				8. Use: ☐ Domestic ☐ Public supply ☐ Industry	
				☐ Irrigation ☐ Air conditioning ☐ Stock	
				☐ Lawn ☒ Oil field water ☐ Other	
				9. Casing: Material <i>PVC</i> Height: <i>Above</i> or below	
				Threaded ☐ Welded ☒ Surface <i>12</i> in.	
				RMP ☐ PVC ☒ Weight <i>112</i> lbs./ft.	
				Dia. <i>2</i> in. to <i>33</i> ft. depth	
				Wall Thickness: <i>inches</i> or	
				Dia. <i>in.</i> to <i>ft.</i> depth	
				Gage No. <i>200</i>	
				10. Screen: Manufacturer's name <i>Pittless Plastic</i>	
				Type <i>PVC</i> Dia. <i>2</i>	
				Slot/gauze <i>3</i> Length <i>10.5</i>	
				Set between <i>25</i> ft. and <i>30</i> ft.	
				<i>ft.</i> and <i>ft.</i>	
				Gravel pack? ☒ Size range of material <i>1/4 - 1/2</i>	
				11. Static water level: <i>10</i> ft. below land surface Date <i>9-1-75</i>	
				12. Pumping level below land surfaces:	
				<i>ft.</i> after <i>hrs.</i> pumping <i>g.p.m.</i>	
				<i>ft.</i> after <i>hrs.</i> pumping <i>g.p.m.</i>	
				Estimated maximum yield <i>g.p.m.</i>	
				13. Water sample submitted: <i>mo./day/yr.</i>	
				☐ Yes ☒ No Date <i>9-1-75</i>	
				14. Well head completion:	
				☐ Pitless adapter <i>inches</i> above grade	
				15. Well grouted? <i>yes</i>	
				With: ☐ Neat cement ☒ Bentonite ☐ Concrete	
				Depth: From <i>0</i> ft. to <i>10</i> ft.	
				16. Nearest source of possible contamination:	
				<i>ft.</i> Direction <i>Type</i>	
				Well disinfected upon completion? ☐ Yes ☐ No	
				17. Pump: ☒ Not installed	
				Manufacturer's name <i>HP</i> Volts <i>g.p.m.</i>	
				Model number <i>HP</i> Volts <i>g.p.m.</i>	
				Length of drop pipe <i>ft.</i> capacity <i>g.p.m.</i>	
				Type:	
				☐ Submersible ☐ Turbine	
				☐ Jet ☐ Reciprocating	
				☐ Centrifugal ☐ Other	
				(Use a second sheet if needed)	
18. Elevation:	19. Remarks:		20. Water well contractor's certification:		
Topography:			This well was drilled under my jurisdiction and this report is true to the best of my knowledge and belief.		
☐ Hill			<i>Myers Water Well 1413</i>		
☒ Slope			Business name <i>Great Bend Ks</i> License No. <i>1/4 1/2 NE SE</i>		
☐ Upland			Address <i>Great Bend Ks</i>		
☐ Valley			Signed <i>Myers</i> Date <i>9-1-75</i>		

Forward the white, blue and pink copies to the Department of Health and Environment

Form WWC-5