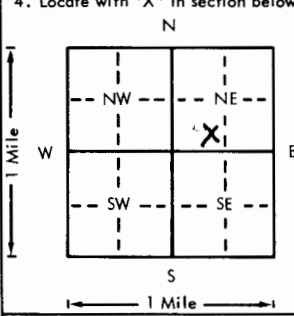


USE TYPEWRITER OR BALL
POINT PEN-PRESS FIRMLY,
PRINT CLEARLY.

WATER WELL RECORD
KSA 82a-1201-1215

Kansas Department of Health and
Environment-Division of Environment
(Water well Contractors)
Topeka, Kansas 66620

Algrim #1

1. Location of well:	County <u>Barton</u>	Fraction <u>SE 1/4 SW NE 1/4</u>	Section number <u>2</u>	Township number <u>20 W</u>	Range number <u>12 S</u>	E/W <u>E/W</u>
2. Distance and direction from nearest town or city: <u>1 South</u>		3. Owner of well: <u>Duke Drilling Co</u>				
Street address of well location if in city: <u>2 1/2 West Ellinwood</u>		City, state, zip code: <u>Great Bend KS</u>				
4. Locate with "X" in section below:		Sketch map:		6. Bore hole dia. <u>5</u> in. Completion date <u>3-23-76</u>		
				Well depth <u>40</u> ft.		
5. Type and color of material		From	To	7. ☒ Cable tool ☒ Rotary ☐ Driven ☐ Dug		
				☐ Hollow rod ☐ Jetted ☐ Bored ☐ Reverse rotary		
				8. Use: ☐ Domestic ☐ Public supply ☐ Industry		
				☐ Irrigation ☐ Air conditioning ☐ Stock		
				☐ Lawn ☒ Oil field water ☐ Other		
				9. Casing: Material <u>Plastic</u> Weight: <u>Above</u> or below		
				Threaded ☐ Welded ☒ Surface <u>12</u> in.		
				RMP ☐ PVC ☒ Weight <u>84</u> lbs./ft.		
				Dia. <u>2</u> in. to <u>40</u> ft. depth Wall Thickness: inches or		
				Dia. <u>2</u> in. to <u>40</u> ft. depth gauge No. <u>200</u>		
				10. Screen: Manufacturer's name <u>Perless Plastic</u>		
				Type <u>PVC</u> Dia. <u>2</u>		
				Slow gauge <u>5</u> Length <u>10</u>		
				Set between <u>30</u> ft. and <u>40</u> ft.		
				Gravel pack? <u>yes</u> Size range of material <u>8-16</u>		
				11. Static water level: <u>10</u> ft. below land surface Date <u>3-23-76</u>		
				12. Pumping level below land surfaces:		
				_____ ft. after _____ hrs. pumping _____ g.p.m.		
				_____ ft. after _____ hrs. pumping _____ g.p.m.		
				Estimated maximum yield _____ g.p.m.		
				13. Water sample submitted: _____ mo./day/yr.		
				☐ Yes ☒ No Date _____		
				14. Well head completion: _____		
				☐ Pitless adapter _____ inches above grade		
				15. Well grouted? <u>yes</u>		
				With: ☐ Neat cement ☒ Bentonite ☐ Concrete		
				Depth: From <u>0</u> ft. to <u>12</u> ft.		
				16. Nearest source of possible contamination:		
				ft. _____ Direction _____ Type _____		
				Well disinfected upon completion? ☐ Yes ☐ No		
				17. Pump: ☒ Not installed		
				Manufacturer's name _____		
				Model number _____ HP _____ Volts _____		
				Length of drop pipe _____ ft. capacity _____ g.p.m.		
				Type:		
				☐ Submersible ☐ Turbine		
				☐ Jet ☐ Reciprocating		
				☐ Centrifugal ☐ Other		
				(Use a second sheet if needed)		
18. Elevation:	19. Remarks:		20. Water well contractor's certification:			
Topography:			This well was drilled under my jurisdiction and this report is true to the best of my knowledge and belief.			
☐ Hill			<u>Myersman Well 143</u>			
☒ Slope			Business name _____ License No. _____			
☐ Upland			Address: <u>Great Bend KS</u>			
☐ Valley			Signed: <u>Arvid A. Myers</u> Date: <u>3-23-76</u>			
				Authorized representative		

Forward the white, blue and pink copies to the Department of Health and Environment

Form WWC-5