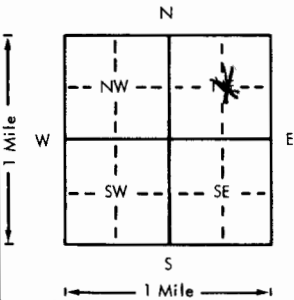


USE TYPEWRITER OR BALL
POINT PEN-PRESS FIRMLY,
PRINT CLEARLY.

WATER WELL RECORD
KSA 82a-1201-1215

Kansas Department of Health and
Environment-Division of Environment
(Water well Contractors)
Topeka, Kansas 66620

1. Location of well:		County <u>Barton</u>	Fraction <u>C/NE</u> 1/4 1/4 1/4	Section number <u>7</u>	Township number <u>T 20</u>	Range number <u>S 12</u> E/W
2. Distance and direction from nearest town or city: <u>1 m S 4 m E 1/4 S 1/4 W of</u> Street address of well location if in city: <u>Great Bend</u>			3. Owner of well: <u>Melvin Dell</u> R.R. or street: City, state, zip code: <u>Elliptwood KS</u>			
4. Locate with "X" in section below: Sketch map: 			6. Bore hole dia. <u>2 1/2</u> in. Completion date <u>8-30-76</u> Well depth <u>92</u> ft. <u>8-30-76</u>			
5. Type and color of material			7. ☐ Cable tool ☒ Rotary ☐ Driven ☐ Dug ☐ Hollow rod ☐ Jetted ☐ Bored ☐ Reverse rotary			
			8. Use: ☐ Domestic ☐ Public supply ☐ Industry ☒ Irrigation ☐ Air conditioning ☐ Stock ☐ Lawn ☐ Oil field water ☐ Other			
			9. Casing: Material <u>Steel</u> Height Above or Below <u>16</u> in. Threaded ☐ Welded ☒ Surface <u>16</u> in. RMP ☐ PVC ☐ Weight ☐ lbs./ft. Dia. <u>1 1/2</u> in. to <u>72</u> ft. depth Wall Thickness: inches or Dia. ☐ in. to ☐ ft. depth Gauge No. <u>7 gauge</u>			
			10. Screen: Manufacturer's name <u>Doerr's</u> Type <u>steel</u> Dia. <u>1 1/2</u> in. Slot/gauge <u>3/16</u> Length <u>92</u> Set between <u>40</u> ft. and <u>72</u> ft. Gravel pack? ☒ Size range of material <u>1/2 3/4 3/8</u>			
			11. Static water level: <u>13</u> ft. below land surface Date <u>5-29-76</u> mo./day/yr.			
(Use a second sheet if needed)			12. Pumping level below land surfaces: <u>10</u> ft. after <u>1</u> hrs. pumping <u>1200</u> g.p.m. <u> </u> ft. after <u> </u> hrs. pumping <u> </u> g.p.m. Estimated maximum yield <u>1400</u> g.p.m.			
			13. Water sample submitted: <u>Yes</u> ☒ No ☐ Date <u>5-29-76</u> mo./day/yr.			
			14. Well head completion: ☐ Pitless adapter ☐ Inches above grade			
			15. Well grouted? ☒ With: ☐ Neat cement ☐ Bentonite ☒ Concrete Depth: From <u>6</u> ft. to <u>16</u> ft.			
			16. Nearest source of possible contamination: ft. <u>1400</u> Direction <u>NW</u> Type <u>septic tank</u> Well disinfected upon completion? ☐ Yes ☐ No			
18. Elevation: Topography: ☐ Hill ☐ Slope ☒ Upland ☐ Valley			17. Pump: ☐ Not installed Manufacturer's name <u>Jacuzzi</u> Model number <u>2-12-45</u> HP <u>40</u> Volts <u>460</u> Length of drop pipe <u>50</u> ft. capacity <u>300</u> g.p.m. Type: ☐ Submersible ☒ Turbine ☐ Jet ☐ Reciprocating ☐ Centrifugal ☐ Other			
			20. Water well contractor's certification: This well was drilled under my jurisdiction and this report is true to the best of my knowledge and belief. <u>Rosneranty - Bennis 134</u> Business name <u>Great Bend KS</u> License No. <u> </u> Address <u>Frederic Barber</u> Date <u>9/9/76</u> Signed <u> </u> Authorized representative			

Forward the white, blue and pink copies to the Department of Health and Environment

Form WWC-5