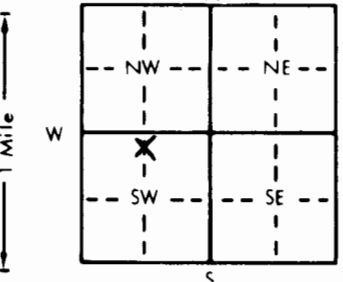


1 LOCATION OF WATER WELL:		Fraction	Section Number	Township Number	Range Number
County: Barton		C N $\frac{1}{2}$ $\frac{1}{4}$ N $\frac{1}{2}$ $\frac{1}{4}$ SW $\frac{1}{4}$	13	T 20 S	R 12 EW
Distance and direction from nearest town or city street address of well if located within city? 2 $\frac{1}{2}$ south 3/4 west of Ellinwood					
2 WATER WELL OWNER: Austin Widener					
RR#, St. Address, Box # : R. R.					
City, State, ZIP Code : Hudson, Ks. 67545					
Board of Agriculture, Division of Water Resources Application Number:					
3 LOCATE WELL'S LOCATION WITH AN "X" IN SECTION BOX:		4 DEPTH OF COMPLETED WELL: 45 ft. ELEVATION:			
		Depth(s) Groundwater Encountered 1... 10 ft. 2... ft. 3... ft.			
		WELL'S STATIC WATER LEVEL 1.0 ft. below land surface measured on mo/day/yr 3-15-84			
		Pump test data: Well water was ft. after hours pumping gpm			
		Est. Yield NA gpm: Well water was ft. after hours pumping gpm			
		Bore Hole Diameter 10 in. to 4.5 ft., and in. to ft.			
WELL WATER TO BE USED AS:					
5 Public water supply 8 Air conditioning 11 Injection well					
☒ Domestic 3 Feedlot 6 Oil field water supply 9 Dewatering 12 Other (Specify below)					
2 Irrigation 4 Industrial 7 Lawn and garden only 10 Observation well STOCK					
Was a chemical/bacteriological sample submitted to Department? Yes No X: If yes, mo/day/yr sample was submitted					
Water Well Disinfected? Yes HTH No					
5 TYPE OF BLANK CASING USED:					
1 Steel 3 RMP (SR) 5 Wrought iron 8 Concrete tile CASING JOINTS: Glued X Clamped					
2 PVC 4 ABS 6 Asbestos-Cement 9 Other (specify below) Welded					
7 Fiberglass Threaded					
Blank casing diameter 5 in. to 25 ft., Dia in. to ft., Dia in. to ft.					
Casing height above land surface 18 in., weight lbs./ft. Wall thickness or gauge No. 258					
TYPE OF SCREEN OR PERFORATION MATERIAL:					
1 Steel 3 Stainless steel 5 Fiberglass 7 PVC 10 Asbestos-cement					
2 Brass 4 Galvanized steel 6 Concrete tile 8 RMP (SR) 11 Other (specify)					
9 ABS 12 None used (open hole)					
SCREEN OR PERFORATION OPENINGS ARE:					
1 Continuous slot 3 Mill slot 5 Gauzed wrapped 8 Saw cut 11 None (open hole)					
2 Louvered shutter 4 Key punched 6 Wire wrapped 9 Drilled holes					
7 Torch cut 10 Other (specify)					
SCREEN-PERFORATED INTERVALS: From 25 ft. to 45 ft., From ft. to ft.					
From ft. to ft., From ft. to ft.					
GRAVEL PACK INTERVALS: From 10 ft. to 45 ft., From ft. to ft.					
From ft. to ft., From ft. to ft.					
6 GROUT MATERIAL: 1 Neat cement 2 Cement grout 3 Bentonite 4 Other					
Grout Intervals: From 0 ft. to 10 ft., From ft. to ft., From ft. to ft.					
What is the nearest source of possible contamination:					
1 Septic tank 4 Lateral lines 7 Pit privy 10 Livestock pens 14 Abandoned water well					
2 Sewer lines 5 Cess pool 8 Sewage lagoon 11 Fuel storage 15 Oil well/Gas well					
3 Watertight sewer lines 6 Seepage pit 9 Feedyard 12 Fertilizer storage 16 Other (specify below)					
13 Insecticide storage NONE					
Direction from well? How many feet?					
FROM	TO	LITHOLOGIC LOG	FROM	TO	LITHOLOGIC LOG
0	4	Sandy top soil			
4	11	Tan sandy clay			
11	36	Sand and gravel			
36	41	Tan sandy clay			
41	45	Sand and gravel			
7 CONTRACTOR'S OR LANDOWNER'S CERTIFICATION: This water well was (1) constructed, (2) reconstructed, or (3) plugged under my jurisdiction and was completed on (mo/day/year) 3-15-84 and this record is true to the best of my knowledge and belief. Kansas Water Well Contractor's License No. 134 This Water Well Record was completed on (mo/day/yr) 3-27-84 under the business name of Rosencrantz-Bemis Ent. by (signature) Lisa Dodson					
INSTRUCTIONS: Use typewriter or ball point pen, PLEASE PRESS FIRMLY and PRINT clearly. Please fill in blanks, underline or circle the correct answers. Send top three copies to Kansas Department of Health and Environment, Division of Environment, Environmental Geology Section, Topeka, KS 66620. Send one to WATER WELL OWNER and retain one for your records.					