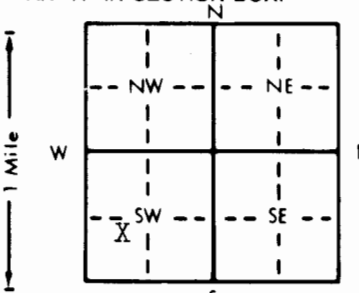


1 LOCATION OF WATER WELL:		Fraction $700' E \frac{1}{4}$ $360' N \frac{1}{4}$ SW $\frac{1}{4}$		Section Number 13		Township Number T 20 S		Range Number R 12W E/W	
County: Barton									
Distance and direction from nearest town or city street address of well if located within city? 2 W, 3 S of Ellinwood, Kansas									
2 WATER WELL OWNER:		Hubert Marchand		Duke Drilling		Marchand #2		T 87-207	
RR#, St. Address, Box # :		Route 1		Box 823		Board of Agriculture, Division of Water Resources			
City, State, ZIP Code :		Ellinwood, Ks. 67526		Great Bend, Ks. 67530		Application Number: 177204 187			
3 LOCATE WELL'S LOCATION WITH AN "X" IN SECTION BOX:		4 DEPTH OF COMPLETED WELL 62 ft. ELEVATION: Unknown							
		Depth(s) Groundwater Encountered 1 15 ft. 2 15 ft. 3 15 ft.							
		WELL'S STATIC WATER LEVEL 15 ft. below land surface measured on mo/day/yr 6/2/87							
		Pump test data: Well water was 15 ft. after 15 hours pumping 60 gpm							
		Est. Yield 60 gpm Well water was 15 ft. after 15 hours pumping 60 gpm							
Bore Hole Diameter 8 in. to 62 ft. and 62 in. to 62 ft.		WELL WATER TO BE USED AS:							
1 Domestic		3 Feedlot		6 Oil field water supply		9 Dewatering		12 Other (Specify below)	
2 Irrigation		4 Industrial		7 Lawn and garden only		10 Observation well			
Was a chemical/bacteriological sample submitted to Department? Yes No; If yes, mo/day/yr sample was submitted									
Water Well Disinfected? Yes No									
5 TYPE OF BLANK CASING USED:		5 Wrought iron		8 Concrete tile		CASING JOINTS: Glued Clamped			
1 Steel		3 RMP (SR)		6 Asbestos-Cement		Welded			
2 PVC		4 ABS		7 Fiberglass		Threaded			
Blank casing diameter 4.5 in. to 42 ft. Dia. 12 in. weight 2.8 lbs./ft. Wall thickness or gauge No. Sch. 40									
Casing height above land surface 12 in. weight 2.8 lbs./ft. Wall thickness or gauge No. Sch. 40									
TYPE OF SCREEN OR PERFORATION MATERIAL:									
1 Steel 3 Stainless steel 5 Fiberglass 7 PVC 10 Asbestos-cement									
2 Brass 4 Galvanized steel 6 Concrete tile 8 RMP (SR) 11 Other (specify)									
3 None used (open hole)									
SCREEN OR PERFORATION OPENINGS ARE:									
1 Continuous slot 3 Mill slot 5 Gauzed wrapped 8 Saw cut 11 None (open hole)									
2 Louvered shutter 4 Key punched 6 Wire wrapped 9 Drilled holes									
7 Torch cut 10 Other (specify)									
SCREEN-PERFORATED INTERVALS: From 42 ft. to 62 ft. From 62 ft. to 62 ft. From 62 ft. to 62 ft.									
GRAVEL PACK INTERVALS: From 20 ft. to 62 ft. From 62 ft. to 62 ft. From 62 ft. to 62 ft.									
6 GROUT MATERIAL: 1 Neat cement 2 Cement grout 3 Bentonite 4 Other									
Grout Intervals: From 0 ft. to 20 ft. From 20 ft. to 62 ft. From 62 ft. to 62 ft.									
What is the nearest source of possible contamination:									
1 Septic tank 4 Lateral lines 7 Pit privy 10 Livestock pens 14 Abandoned water well									
2 Sewer lines 5 Cess pool 8 Sewage lagoon 11 Fuel storage 15 Oil well/Gas well									
3 Watertight sewer lines 6 Seepage pit 9 Feedyard 12 Fertilizer storage 16 Other (specify below)									
13 Insecticide storage									
Direction from well? South How many feet? 60									
FROM TO LITHOLOGIC LOG FROM TO LITHOLOGIC LOG									
0 30 Clay									
30 62 Sand and Gravel									
7 CONTRACTOR'S OR LANDOWNER'S CERTIFICATION: This water well was (1) constructed, (2) reconstructed, or (3) plugged under my jurisdiction and was completed on (mo/day/year) 6/2/87 and this record is true to the best of my knowledge and belief. Kansas Water Well Contractor's License No. 186 This Water Well Record was completed on (mo/day/yr) 8/23/87 under the business name of Kelly's Water Well Service by (signature)									
INSTRUCTIONS: Use typewriter or ball point pen. PLEASE PRESS FIRMLY and PRINT clearly. Please fill in blanks. underline or circle the correct answers. Send top three copies to Kansas Department of Health and Environment, Bureau of Water Protection, Topeka, Kansas 66620-7320. Telephone: 913-862-9360. Send one to WATER WELL OWNER and retain one for your records.									