

BUCKBEE #4

WATER WELL RECORD

Form WWC-5

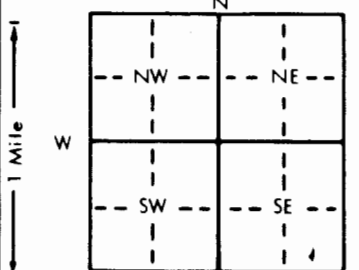
KSA 82a-1212

1 LOCATION OF WATER WELL:	Fraction	Section Number	Township Number	Range Number
County: <u>BARTON</u>	<u>15 1/4 SE 1/4 SE 1/4</u>	<u>15</u>	T <u>20</u> S	R <u>12</u> E <u>W</u>

Distance and direction from nearest town or city street address of well if located within city?

ELIWOOD 35 2 1/8 W NORTHSIDE.

2 WATER WELL OWNER: <u>STERLING DRILLING CO.</u>	Board of Agriculture, Division of Water Resources
RR#, St. Address, Box #: <u>BOX 129</u>	Application Number: <u>T85-247</u>
City, State, ZIP Code: <u>STERLING, KS 67579</u>	

3 LOCATE WELL'S LOCATION WITH AN "X" IN SECTION BOX:	4 DEPTH OF COMPLETED WELL: <u>65</u> ft. ELEVATION:
	Depth(s) Groundwater Encountered 1. <u>36</u> ft. 2. <u>49</u> ft. 3. <u>75-85</u> ft.
	WELL'S STATIC WATER LEVEL <u>18</u> ft. below land surface measured on mo/day/yr <u>7-28-85</u>
	Pump test data: Well water was <u>1</u> ft. after <u>1</u> hours pumping <u>1</u> gpm
	Est. Yield <u>1</u> gpm: Well water was <u>1</u> ft. after <u>1</u> hours pumping <u>1</u> gpm
	Bore Hole Diameter <u>7 1/8</u> in. to <u>65</u> ft., and <u>1</u> in. to <u>1</u> ft.
	WELL WATER TO BE USED AS:
	1 Domestic 3 Feedlot 6 Oil field water supply 9 Dewatering 12 Other (Specify below)
	2 Irrigation 4 Industrial 7 Lawn and garden only 10 Observation well
	Was a chemical/bacteriological sample submitted to Department? Yes <u>No</u> ; If yes, mo/day/yr sample was submitted <u>1</u>
	Water Well Disinfected? Yes <u>No</u>

5 TYPE OF BLANK CASING USED:	5 Wrought iron	8 Concrete tile	CASING JOINTS: Glued <u>XY</u> Clamped <u>1</u>
1 Steel	3 RMP (SR)	6 Asbestos-Cement	9 Other (specify below) <u>1</u>
2 <u>PVC</u>	4 ABS	7 Fiberglass	10 Asbestos-cement
Blank casing diameter <u>5</u> in. to <u>45</u> ft., Dia <u>12</u> in. to <u>2 1/2</u> ft., Dia <u>2 1/2</u> in. to <u>2 1/2</u> ft.			
Casing height above land surface <u>12</u> in., weight <u>2 1/2</u> lbs./ft. Wall thickness or gauge No. <u>2 1/2</u>			
TYPE OF SCREEN OR PERFORATION MATERIAL:	7 <u>PVC</u>	10 Asbestos-cement	
1 Steel	3 Stainless steel	5 Fiberglass	8 RMP (SR)
2 Brass	4 Galvanized steel	6 Concrete tile	9 ABS
SCREEN OR PERFORATION OPENINGS ARE: <u>18</u>	5 Gauzed wrapped	8 Saw cut	11 None (open hole)
1 Continuous slot	3 Mill slot	6 Wire wrapped	9 Drilled holes
2 Louvered shutter	4 Key punched	7 Torch cut	10 Other (specify) <u>1</u>
SCREEN-PERFORATED INTERVALS: From <u>45</u> ft. to <u>65</u> ft., From <u>65</u> ft. to <u>65</u> ft., From <u>65</u> ft. to <u>65</u> ft.			
GRAVEL PACK INTERVALS: From <u>35</u> ft. to <u>65</u> ft., From <u>65</u> ft. to <u>65</u> ft., From <u>65</u> ft. to <u>65</u> ft.			

6 GROUT MATERIAL:	1 Neat cement	2 Cement grout	3 Bentonite	4 Other <u>1</u>
Grout Intervals: From <u>0</u> ft. to <u>1.0</u> ft., From <u>1.0</u> ft. to <u>1.0</u> ft., From <u>1.0</u> ft. to <u>1.0</u> ft.				
What is the nearest source of possible contamination: <u>NONE</u>	10 Livestock pens	14 Abandoned water well		
1 Septic tank	4 Lateral lines	7 Pit privy	11 Fuel storage	15 Oil well/Gas well
2 Sewer lines	5 Cess pool	8 Sewage lagoon	12 Fertilizer storage	16 Other (specify below)
3 Watertight sewer lines	6 Seepage pit	9 Feedyard	13 Insecticide storage	
Direction from well?		How many feet?		

FROM	TO	LITHOLOGIC LOG	FROM	TO	LITHOLOGIC LOG
0	4	TOP SOIL			
4	10	FINE SAND			
10	15	CLAY			
15	30	FINE SAND			
30	35	CLAY			
35	45	GRAVEL			
45	49	CLAY			
49	65	GRAVEL			

7 CONTRACTOR'S OR LANDOWNER'S CERTIFICATION: This water well was (1) <u>constructed</u> , (2) reconstructed, or (3) plugged under my jurisdiction and was completed on (mo/day/year) <u>7-28-85</u> and this record is true to the best of my knowledge and belief. Kansas Water Well Contractor's License No. <u>389</u> This Water Well Record was completed on (mo/day/yr) <u>7-12-85</u> under the business name of <u>REISER WATER WELL SERV. INC.</u> by (signature) <u>Reiser</u>
INSTRUCTIONS: Use typewriter or ball point pen, PLEASE PRESS FIRMLY and PRINT clearly. Please fill in blanks, underline or circle the correct answers. Send top three copies to Kansas Department of Health and Environment, Division of Environment, Environmental Geology Section, Topeka, KS 66620. Send one to WATER WELL OWNER and retain one for your records.