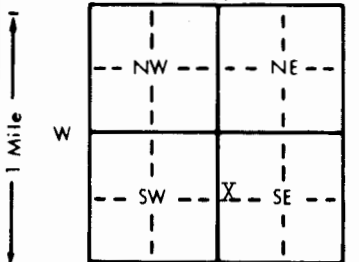


1 LOCATION OF WATER WELL: County: Barton		Fraction SW 1/4 NW 1/4 SE 1/4		Section Number 18	Township Number T 20 S		Range Number R 12W E/W	
Distance and direction from nearest town or city street address of well if located within city? 4 S, 1 W of Dartmouth, Kansas								
2 WATER WELL OWNER: Chris Batchman				Woodmar-Iannitti		Batchman No. 5		
RR#, St. Address, Box #: Route 2				104 S. Broadway		Board of Agriculture, Division of Water Resources		
City, State, ZIP Code: Ellinwood, Ks. 67526				Wichita, Ks. 67202		Application Number: Unknown		
3 LOCATE WELL'S LOCATION WITH AN "X" IN SECTION BOX:				4 DEPTH OF COMPLETED WELL: 60 ft. ELEVATION: Unknown				
				Depth(s) Groundwater Encountered 1. 20 ft. 2. ft. 3. ft.				
				WELL'S STATIC WATER LEVEL 20 ft. below land surface measured on mo/day/yr 11/28/84				
				Pump test data: Well water was ft. after hours pumping gpm				
				Est. Yield 60 gpm Well water was ft. after hours pumping gpm				
Bore Hole Diameter 8 in. to 60 ft. and in. to ft.				WELL WATER TO BE USED AS:				
1 Domestic 3 Feedlot 6 Oil field water supply 8 Air conditioning 11 Injection well				2 Irrigation 4 Industrial 7 Lawn and garden only 10 Observation well				
12 Other (Specify below)				Was a chemical/bacteriological sample submitted to Department? Yes No If yes, mo/day/yr sample was submitted				
5 TYPE OF BLANK CASING USED:				CASING JOINTS: Glued Clamped				
1 Steel 3 RMP (SR) 5 Wrought iron 8 Concrete tile				2 PVC 4 ABS 6 Asbestos-Cement 9 Other (specify below) Welded				
7 Fiberglass Threaded				Blank casing diameter 5 in. to 40 ft. Dia in. to ft. Dia in. to ft.				
Casing height above land surface 12 in. weight 2.8 lbs./ft. Wall thickness or gauge No. Sch. 40				TYPE OF SCREEN OR PERFORATION MATERIAL:				
1 Steel 3 Stainless steel 5 Fiberglass 8 RMP (SR) 10 Asbestos-cement				2 Brass 4 Galvanized steel 6 Concrete tile 9 ABS 11 Other (specify)				
12 None used (open hole)				SCREEN OR PERFORATION OPENINGS ARE:				
1 Continuous slot 3 Mill slot 5 Gauzed wrapped 8 Saw cut 11 None (open hole)				2 Louvered shutter 4 Key punched 6 Wire wrapped 9 Drilled holes				
7 Torch cut 10 Other (specify)				SCREEN-PERFORATED INTERVALS: From 40 ft. to 60 ft. From ft. to ft. From ft. to ft.				
GRAVEL PACK INTERVALS: From 10 ft. to 60 ft. From ft. to ft. From ft. to ft.				6 GROUT MATERIAL: 1 Neat cement 2 Cement grout 3 Bentonite 4 Other				
Grout Intervals: From 0 ft. to 10 ft. From ft. to ft. From ft. to ft.				What is the nearest source of possible contamination:				
1 Septic tank 4 Lateral lines 7 Pit privy 10 Livestock pens 14 Abandoned water well				2 Sewer lines 5 Cess pool 8 Sewage lagoon 11 Fuel storage 15 Oil well/Gas well				
3 Watertight sewer lines 6 Seepage pit 9 Feedyard 12 Fertilizer storage 16 Other (specify below)				13 Insecticide storage				
Direction from well? South				How many feet? 60				
FROM TO LITHOLOGIC LOG			FROM TO LITHOLOGIC LOG					
0 20 Clay								
20 60 Sand and Gravel								
7 CONTRACTOR'S OR LANDOWNER'S CERTIFICATION: This water well was (1) constructed (2) reconstructed, or (3) plugged under my jurisdiction and was completed on (mo/day/year) 11/28/84 and this record is true to the best of my knowledge and belief. Kansas Water Well Contractor's License No. 186 This Water Well Record was completed on (mo/day/yr) 12/31/84 under the business name of Kellys Water Well Service by (signature) Jerry S. [Signature]								
INSTRUCTIONS: Use typewriter or ball point pen, PLEASE PRESS FIRMLY and PRINT clearly. Please fill in blanks, underline or circle the correct answers. Send top three copies to Kansas Department of Health and Environment, Division of Environment, Environmental Geology Section, Topeka, KS 66620. Send one to WATER WELL OWNER and retain one for your records.								