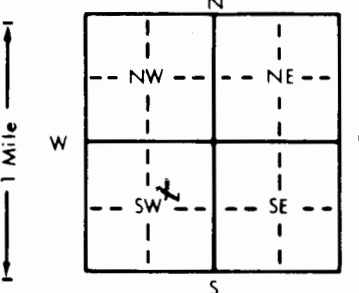


1 LOCATION OF WATER WELL:		Fraction	Section Number	Township Number	Range Number
County: Barton		SW 1/4 NE 1/4 SW 1/4	19	T 20 S	R 12 E/W
Distance and direction from nearest town or city street address of well if located within city?					
4 south 2 3/4 east of Great Bend					
2 WATER WELL OWNER:		Wheatstate Drilling		Board of Agriculture, Division of Water Resources	
RR#, St. Address, Box # :		Ellinwood, Ks. Box 947		Application Number: T84-86	
City, State, ZIP Code :		Pratt, Ks. 67124			
3 LOCATE WELL'S LOCATION WITH AN "X" IN SECTION BOX:		4 DEPTH OF COMPLETED WELL: 65 ft. ELEVATION:			
		Depth(s) Groundwater Encountered 1. 1.9 ft. 2. ft. 3. ft.			
		WELL'S STATIC WATER LEVEL 1.9 ft. below land surface measured on mo/day/yr 2-9-84			
		Pump test data: Well water was ft. after hours pumping gpm			
		Est. Yield NA gpm: Well water was ft. after hours pumping gpm			
		Bore Hole Diameter 1.0 in. to .65 ft. and in. to ft.			
		WELL WATER TO BE USED AS: 5 Public water supply 8 Air conditioning 11 Injection well			
		1 Domestic 3 Feedlot 6 Oil field water supply 9 Dewatering 12 Other (Specify below)			
		2 Irrigation 4 Industrial 7 Lawn and garden only 10 Observation well			
		Was a chemical/bacteriological sample submitted to Department? Yes No X; If yes, mo/day/yr sample was submitted			
		Water Well Disinfected? Yes HTH No			
5 TYPE OF BLANK CASING USED:		5 Wrought iron 8 Concrete tile		CASING JOINTS: Glued X Clamped	
1 Steel 3 RMP (SR)		6 Asbestos-Cement 9 Other (specify below)		Welded	
2 PVC 4 ABS		7 Fiberglass		Threaded	
Blank casing diameter 5 in. to .45 ft. Dia		in. to ft. Dia		in. to ft.	
Casing height above land surface 18 in., weight		lbs./ft. Wall thickness or gauge No. 258			
TYPE OF SCREEN OR PERFORATION MATERIAL:		7 PVC 10 Asbestos-cement			
1 Steel 3 Stainless steel 5 Fiberglass 8 RMP (SR)		11 Other (specify)			
2 Brass 4 Galvanized steel 6 Concrete tile 9 ABS		12 None used (open hole)			
SCREEN OR PERFORATION OPENINGS ARE:		5 Gauzed wrapped 8 Saw cut 11 None (open hole)			
1 Continuous slot 3 Mill slot 6 Wire wrapped 9 Drilled holes		10 Other (specify)			
2 Louvered shutter 4 Key punched 7 Torch cut					
SCREEN-PERFORATED INTERVALS:		From 45 ft. to 65 ft. From ft. to ft.			
GRAVEL PACK INTERVALS:		From 10 ft. to 65 ft. From ft. to ft.			
6 GROUT MATERIAL:		1 Neat cement 2 Cement grout 3 Bentonite 4 Other			
Grout Intervals: From 0 ft. to 10 ft. From ft. to ft. From ft. to ft.					
What is the nearest source of possible contamination:		10 Livestock pens 14 Abandoned water well			
1 Septic tank 4 Lateral lines 7 Pit privy 11 Fuel storage 15 Oil well/Gas well		12 Fertilizer storage 16 Other (specify below)			
2 Sewer lines 5 Cess pool 8 Sewage lagoon 13 Insecticide storage					
3 Watertight sewer lines 6 Seepage pit 9 Feedyard					
Direction from well? west		How many feet? 100			
FROM	TO	LITHOLOGIC LOG	FROM	TO	LITHOLOGIC LOG
0	2	Top soil			
2	19	Clay			
19	31	Sand and gravel			
31	36	Clay			
36	58	Sand and gravel w/clay layers			
58	65	Green clay			
7 CONTRACTOR'S OR LANDOWNER'S CERTIFICATION: This water well was (1) constructed, (2) reconstructed, or (3) plugged under my jurisdiction and was completed on (mo/day/year) 2-9-84 and this record is true to the best of my knowledge and belief. Kansas Water Well Contractor's License No. 134 This Water Well Record was completed on (mo/day/yr) 2-14-84 under the business name of Rosencrantz-Bemis Ent. by (signature) Aora Dodson					
INSTRUCTIONS: Use typewriter or ball point pen, PLEASE PRESS FIRMLY and PRINT clearly. Please fill in blanks, underline or circle the correct answers. Send top three copies to Kansas Department of Health and Environment, Division of Environment, Environmental Geology Section, Topeka, KS 66620. Send one to WATER WELL OWNER and retain one for your records.					