


Distance and direction from nearest town or city street address of well if located within city?

2 WATER WELL OWNER: J.W. DRILLING CO. INC. R.F. MARCHAND, ELLINWOOD, K.

City, State, ZIP Code : WICHITA, KS 67202 Application Number: T84-314

WELL'S STATIC WATER LEVEL 20 ft. below land surface measured on mo/day/yr. 8-8-84

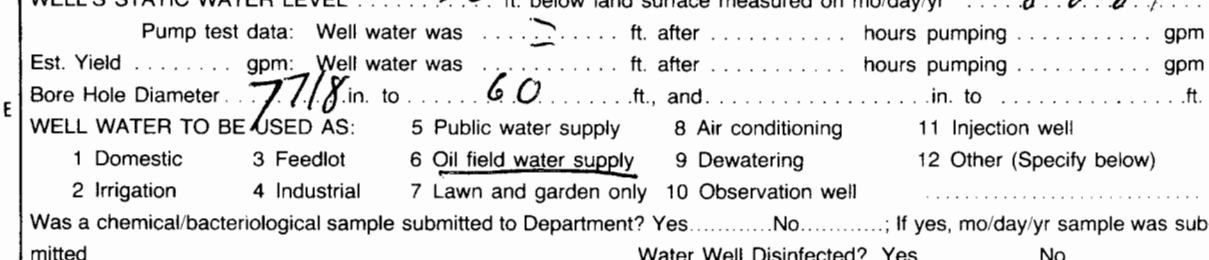

1 Steel 3 RMP (SR) 6 Asbestos-Cement 9 Other (specify below) Welded

Casing height above land surface 12 in. weight 2.65 lbs./ft. Wall thickness or gauge No. 214r

1 Steel 3 Stainless steel 5 Fiberglass 8 RMP (SR) 11 Other (specify)

SCREEN OR PERFORATION OPENINGS ARE: 1/8 5 Gauzed wrapped 8 Saw cut 11 None (open hole)

SCREEN-PERFORATED INTERVALS: From 40 ft to 60 ft From _____ ft to _____ ft

GRAVEL PACK INTERVALS: From 30 ft. to 60 ft., From _____ ft. to _____ ft.

Grout Intervals: From 0 ft to 10 ft From ft to ft From ft to ft

1 Septic tank	4 Lateral lines	7 Pit privy	11 Fuel storage	15 Oil well/Gas well
---------------	-----------------	-------------	-----------------	----------------------

Direction from well? _____

O	4	055 AND
---	---	---------

7 CONTRACTOR'S OR LANDOWNER'S CERTIFICATION: This water well was (1) constructed, (2) reconstructed, or (3) plugged under my jurisdiction and was

Water Well Contractor's License No. 389 This Water Well Record was completed on (mo/day/yr) 8-22-84

three copies to Kansas Department of Health and Environment, Division of Environment, Environmental Geology Section, Topeka, KS 66620. Send one to WATER WELL OWNER and retain one for your records.