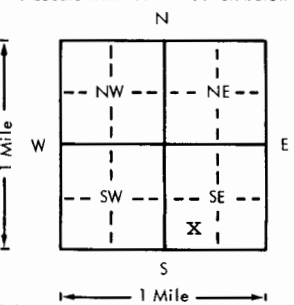


USE TYPEWRITER OR BALL-
POINT PEN-PRESS FIRMLY,
PRINT CLEARLY.

WATER WELL RECORD
KSA 82a-1201-1215

Kansas Department of Health and
Environment-Division of Environment
(Water well Contractors)
Topeka, Kansas 66620

1. Location of well:		County Barton	Fraction 1/4 SW 1/4 SE 1/4	Section number 24	Township number T 20 S	Range number R 12 E
2. Distance and direction from nearest town or city: 4 mi. South of Ellinwood, KS Street address of well location if in city:				3. Owner of well: Kenneth Scheufler R.R. or street: Route 2 City, state, zip code: Ellinwood, KS 67526		
4. Locate with "X" in section below: 			Sketch map:		6. Bore hole dia. 5 1/2 in. Completion date 12-12-75 Well depth 62 ft.	
5. Type and color of material			From	To	7. ☐ Cable tool ☒ Rotary ☐ Driven ☐ Dug ☐ Hollow rod ☐ Jetted ☐ Bored ☐ Reverse rotary	
Sand & sandy clay			0	8	8. Use: ☐ Domestic ☐ Public supply ☐ Industry ☐ Irrigation ☐ Air conditioning ☒ Stock ☐ Lawn ☐ Oil field water ☐ Other	
Sandy clay			8	42	9. Casing: Material Steel & PVC Height: Above or below Threaded ☐ Welded ☒ Surface 12 in. RMP ☐ PVC ☒ Weight 4.4 & 5 lbs./ft. Dia. 2 in. to 42 ft. depth Wall Thickness: inches or Dia. 2 in. to 52 ft. depth gage No. 188 & 091	
Sand & gravel			42	47	10. Screen: Manufacturer's name Peerless Plastics Type PVC Dia. 2" Slot gauge 1/8 Length 10' Set between 52 ft. and 62 ft. ft. and ft. Gravel pack? Yes Size range of material 3/8-200	
Yellow clay			47	51	11. Static water level: mo./day/yr. 28 ft. below land surface Date 12-12-75	
Gravel			51	54	12. Pumping level below land surfaces: N/C ft. after hrs. pumping g.p.m. ft. after hrs. pumping g.p.m. Estimated maximum yield g.p.m.	
Yellow clay			54	56	13. Water sample submitted: mo./day/yr. ☐ Yes ☒ No Date	
Sand & gravel			56	62	14. Well head completion: ☐ Pitless adapter 12 inches above grade	
					15. Well grouted? Yes With: ☒ Neat cement ☐ Bentonite ☐ Concrete Depth: From 0 ft. to 10 ft.	
					16. Nearest source of possible contamination: ft. Direction Type NONE KNOWN Well disinfected upon completion? ☒ Yes ☐ No	
					17. Pump: ☒ Not installed Manufacturer's name Model number HP Volts Length of drop pipe ft. capacity g.p.m. Type: ☐ Submersible ☐ Turbine ☐ Jet ☐ Reciprocating ☐ Centrifugal ☐ Other	
			(Use a second sheet if needed)			
18. Elevation: Topography: ☐ Hill ☐ Slope ☐ Upland ☐ Valley		19. Remarks:		20. Water well contractor's certification: This well was drilled under my jurisdiction and this report is true to the best of my knowledge and belief. Clarke Well & Eq., Inc. 185 Business name License No. Address Great Bend, KS Signed [Signature] Date 12-12-75 Authorized representative		

Forward the white, blue and pink copies to the Department of Health and Environment

Form WWC-5