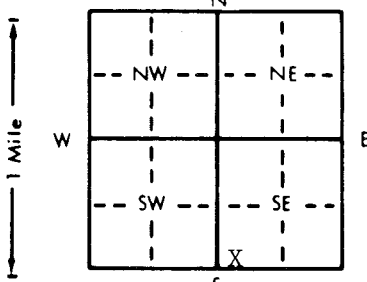


1 LOCATION OF WATER WELL: County: Barton	Fraction SW 1/4 SW 1/4 SE 1/4	Section Number 24	Township Number T 20 S	Range Number R 12 E/W
---	----------------------------------	----------------------	---------------------------	--------------------------

Distance and direction from nearest town or city street address of well if located within city?

4 Miles south, 1/2 mile west of Ellinwood, KS

2 WATER WELL OWNER: Kenneth Scheufler	Board of Agriculture, Division of Water Resources
RR#, St. Address, Box #: Rt 2	Application Number:
City, State, ZIP Code: Ellinwood, KS 67526	

3 LOCATE WELL'S LOCATION WITH AN "X" IN SECTION BOX: 	4 DEPTH OF COMPLETED WELL: 70 ft. ELEVATION: Depth(s) Groundwater Encountered 1. ft. 2. ft. 3. ft. WELL'S STATIC WATER LEVEL: 27 ft. below land surface measured on mo/day/yr Pump test data: Well water was not ch'd. ft. after hours pumping gpm Est. Yield unknown gpm: Well water was ft. after hours pumping gpm Bore Hole Diameter: 9 in. to 68 ft., and in. to ft. WELL WATER TO BE USED AS: ① Domestic 3 Feedlot 6 Oil field water supply 9 Dewatering 12 Other (Specify below) stock 2 Irrigation 4 Industrial 7 Lawn and garden only 10 Monitoring well Was a chemical/bacteriological sample submitted to Department? Yes No X If yes, mo/day/yr sample was submitted Water Well Disinfected? Yes No X
--	---

5 TYPE OF BLANK CASING USED: 1 Steel 3 RMP (SR) 5 Wrought iron 8 Concrete tile CASING JOINTS: Glued X Clamped 2 PVC 4 ABS 6 Asbestos-Cement 9 Other (specify below) Welded Blank casing diameter in. to 70 ft. Dia in. to ft. Dia in. to ft. Casing height above land surface: 24 in. weight 2.277 lbs./ft. Wall thickness or gauge No. 214 TYPE OF SCREEN OR PERFORATION MATERIAL: 1 Steel 3 Stainless steel 5 Fiberglass 8 RMP (SR) 10 Asbestos-cement 11 Other (specify) 2 Brass 4 Galvanized steel 6 Concrete tile 9 ABS 12 None used (open hole) SCREEN OR PERFORATION OPENINGS ARE: 1 Continuous slot 3 Mill slot 5 Gauzed wrapped 8 Saw cut 11 None (open hole) 2 Louvered shutter 4 Key punched 6 Wire wrapped 9 Drilled holes SCREEN-PERFORATED INTERVALS: From 52 ft. to 66 ft. From ft. to ft. GRAVEL PACK INTERVALS: From 20 ft. to 68 ft. From ft. to ft. From ft. to ft. From ft. to ft.

6 GROUT MATERIAL: 1 Neat cement 2 Cement grout 3 Bentonite 4 Other
Grout Intervals: From 0 ft. to 20 ft. From ft. to ft. From ft. to ft.
What is the nearest source of possible contamination: 1 Septic tank 4 Lateral lines 7 Pit privy 10 Livestock pens 14 Abandoned water well 2 Sewer lines 5 Cess pool 8 Sewage lagoon 11 Fuel storage 15 Oil well/Gas well 3 Watertight sewer lines 6 Seepage pit 9 Feedyard 12 Fertilizer storage 16 Other (specify below) 13 Insecticide storage none unknown

Direction from well?		How many feet?	
FROM	TO	FROM	TO
0	4	8	52
4	44	52	66
44	68	66	68
LITHOLOGIC LOG		PLUGGING INTERVALS	
Fine sand topsoil		XXXXX	
clay brown sandy		XXXXX	
sand & gravel Med to fine to coarse		XXXXX	

7 CONTRACTOR'S OR LANDOWNER'S CERTIFICATION: This water well was (1) constructed, (2) reconstructed, or (3) plugged under my jurisdiction and was completed on (mo/day/year) 12-2-88 and this record is true to the best of my knowledge and belief. Kansas Water Well Contractor's License No. 185 This Water Well Record was completed on (mo/day/yr) 12-5-88 under the business name of Clarke Well & Equipment Co., Inc. by (signature)

INSTRUCTIONS: Use typewriter or ball point pen. PLEASE PRESS FIRMLY and PRINT clearly. Please fill in blanks, underline or circle the correct answers. Send top three copies to Kansas Department of Health and Environment, Bureau of Water Protection, Topeka, Kansas 66620-7320. Telephone: 913-296-5514. Send one to WATER WELL OWNER and retain one for your records.