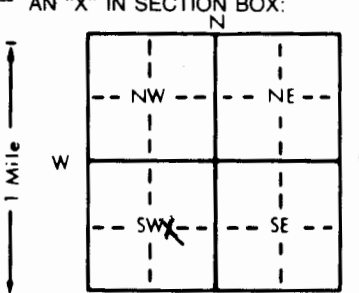


1 LOCATION OF WATER WELL:	Fraction	Section Number	Township Number	Range Number
County: Barton	near 1/4 c 1/4 SW 1/4	30	T 20 S	R 12 E/W

Distance and direction from nearest town or city street address of well if located within city?

5 south of Great Bend 3 east.

2 WATER WELL OWNER:	Paul Chisholm	Board of Agriculture, Division of Water Resources
RR#, St. Address, Box # :	Rt. 2	
City, State, ZIP Code	Great Bend, Ks. 67530	Application Number: 26162

3 LOCATE WELL'S LOCATION WITH AN "X" IN SECTION BOX:	4 DEPTH OF COMPLETED WELL: 95 ft. ELEVATION:
	Depth(s) Groundwater Encountered 1. ft. 2. ft. 3. ft. WELL'S STATIC WATER LEVEL . 62 ft. below land surface measured on mo/day/yr . 7-5-91 Pump test data: Well water was . 62 ft. after . 2 hours pumping . 850 gpm Est. Yield . 1,000 . gpm: Well water was . 66 ft. after hours pumping . 1,000 . gpm Bore Hole Diameter 26 . in. to 95 ft., and in. to ft. WELL WATER TO BE USED AS: 5 Public water supply 8 Air conditioning 11 Injection well 1 Domestic 3 Feedlot 6 Oil field water supply 9 Dewatering 12 Other (Specify below) 2 Irrigation 4 Industrial 7 Lawn and garden only 10 Monitoring well Was a chemical/bacteriological sample submitted to Department? Yes No X If yes, mo/day/yr sample was sub- mitted Water Well Disinfected? Yes hth No

5 TYPE OF BLANK CASING USED:	5 Wrought iron	8 Concrete tile	CASING JOINTS: Glued X Clamped	
1 Steel	3 RMP (SR)	6 Asbestos-Cement	9 Other (specify below)	Welded
2 PVC	4 ABS	7 Fiberglass		Threaded
Blank casing diameter 16 in. to 60 ft., Dia in. to ft., Dia in. to ft.				
Casing height above land surface 12 in., weight . . SDR 32.5 lbs./ft. Wall thickness or gauge No.				
TYPE OF SCREEN OR PERFORATION MATERIAL:	7 PVC	10 Asbestos-cement		
1 Steel	3 Stainless steel	5 Fiberglass	8 RMP (SR)	11 Other (specify)
2 Brass	4 Galvanized steel	6 Concrete tile	9 ABS	12 None used (open hole)
SCREEN OR PERFORATION OPENINGS ARE:	5 Gauzed wrapped	8 Saw cut	11 None (open hole)	
1 Continuous slot	3 Mill slot	6 Wire wrapped	9 Drilled holes	
2 Louvered shutter	4 Key punched	7 Torch cut	10 Other (specify)	
SCREEN-PERFORATED INTERVALS:	From 60 ft. to 95 ft., From ft. to ft.			
	From ft. to ft., From ft. to ft.			
GRAVEL PACK INTERVALS:	From 20 ft. to 95 ft., From ft. to ft.			
	From ft. to ft., From ft. to ft.			

6 GROUT MATERIAL:	1 Neat cement	2 Cement grout	3 Bentonite	4 Other
Grout Intervals: From . . 0 ft. to . . 20 ft., From ft. to ft., From ft. to ft.				
What is the nearest source of possible contamination:	10 Livestock pens	14 Abandoned water well		
1 Septic tank	4 Lateral lines	7 Pit privy	11 Fuel storage	15 Oil well/Gas well
2 Sewer lines	5 Cess pool	8 Sewage lagoon	12 Fertilizer storage	16 Other (specify below)
3 Watertight sewer lines	6 Seepage pit	9 Feedyard	13 Insecticide storage	none

Direction from well?		How many feet?			
FROM	TO	LITHOLOGIC LOG	FROM	TO	PLUGGING INTERVALS
0	3	Top soil			
3	15	Sandy brown clay			
15	23	Brown clay			
23	48	Sand and gravel			
48	51	Gray clay			
51	73	Sand and gravel			
73	75	Sand and gravel with clay streaks			
75	95	Sand and gravel			

7 CONTRACTOR'S OR LANDOWNER'S CERTIFICATION: This water well was (1) constructed, (2) reconstructed, or (3) plugged under my jurisdiction and was completed on (mo/day/year) 7-11-91 and this record is true to the best of my knowledge and belief. Kansas Water Well Contractor's License No. . . . 134 This Water Well Record was completed on (mo/day/yr) 7-22-91 under the business name of Rosencrantz-Bemis by (signature) Fredrick Godson

INSTRUCTIONS: Use typewriter or ball point pen. PLEASE PRESS FIRMLY and PRINT clearly. Please fill in blanks, underline or circle the correct answers. Send top three copies to Kansas Department of Health and Environment, Bureau of Water, Topeka, Kansas 66620-7320. Telephone: 913-296-5545. Send one to WATER WELL OWNER and retain one for your records.