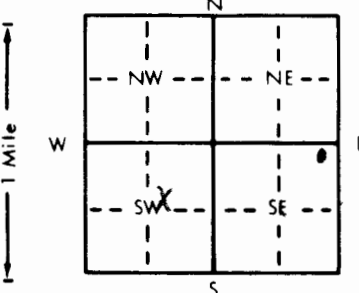


DIRKS

WATER WELL RECORD Form WWC-5 KSA 82a-1212

1 LOCATION OF WATER WELL:		Fraction <u>SW</u>	Section Number <u>32</u>	Township Number <u>T 20 S</u>	Range Number <u>R 12 EW</u>
County: <u>Barton</u>					
Distance and direction from nearest town or city street address of well if located within city? <u>GREAT BEND 4 1/2 E 5 1/2 S WESTSIDE</u>					
2 WATER WELL OWNER: <u>L.D. DRILLING CO.</u>		<u>E.B. DIRKS, GREAT BEND, KS</u>			
RR#, St. Address, Box #: <u>RT-1 BOX 183 B</u>		Board of Agriculture, Division of Water Resources			
City, State, ZIP Code: <u>GREAT BEND, KS 67530</u>		Application Number: <u>T84-861</u>			
3 LOCATE WELL'S LOCATION WITH AN "X" IN SECTION BOX:		4 DEPTH OF COMPLETED WELL: <u>70</u> ft. ELEVATION: <u>70</u> ft.			
		Depth(s) Groundwater Encountered 1. <u>24</u> ft. 2. <u>55</u> ft. 3. <u>1013.89</u> ft.			
		WELL'S STATIC WATER LEVEL <u>21</u> ft. below land surface measured on mo/day/yr <u>10-13-89</u>			
		Bore Hole Diameter <u>7 7/8</u> in. to <u>70</u> ft. and <u>70</u> in. to <u>70</u> ft.			
		WELL WATER TO BE USED AS: 5 Public water supply 8 Air conditioning 11 Injection well			
		1 Domestic 3 Feedlot 6 Oil field water supply 9 Dewatering 12 Other (Specify below)			
		2 Irrigation 4 Industrial 7 Lawn and garden only 10 Observation well			
		Was a chemical/bacteriological sample submitted to Department? Yes <u> </u> No <u> </u> ; If yes, mo/day/yr sample was submitted <u> </u>			
		Water Well Disinfected? Yes <u> </u> No <u> </u>			
5 TYPE OF BLANK CASING USED:					
1 Steel		3 RMP (SR)		5 Wrought iron	
2 PVC		4 ABS		6 Asbestos-Cement	
				7 Fiberglass	
Casing height above land surface <u>12</u> in., weight <u>2.65</u> lbs./ft. Wall thickness or gauge No. <u>214</u>					
TYPE OF SCREEN OR PERFORATION MATERIAL:					
1 Steel		3 Stainless steel		5 Fiberglass	
2 Brass		4 Galvanized steel		6 Concrete tile	
				7 PVC	
				8 RMP (SR)	
				9 ABS	
				10 Asbestos-cement	
				11 Other (specify) <u> </u>	
				12 None used (open hole)	
SCREEN OR PERFORATION OPENINGS ARE: <u>1/8</u>					
1 Continuous slot		3 Mill slot		5 Gauzed wrapped	
2 Louvered shutter		4 Key punched		6 Wire wrapped	
				7 Torch cut	
				8 Saw cut	
				9 Drilled holes	
				10 Other (specify) <u> </u>	
				11 None (open hole)	
6 GROUT MATERIAL: 1 Neat cement 2 Cement grout 3 Bentonite 4 Other <u> </u>					
What is the nearest source of possible contamination: <u>NONE</u>					
1 Septic tank		4 Lateral lines		7 Pit privy	
2 Sewer lines		5 Cess pool		8 Sewage lagoon	
3 Watertight sewer lines		6 Seepage pit		9 Feedyard	
				10 Livestock pens	
				11 Fuel storage	
				12 Fertilizer storage	
				13 Insecticide storage	
				14 Abandoned water well	
				15 Oil well/Gas well	
				16 Other (specify below) <u> </u>	
Direction from well? <u> </u> How many feet? <u> </u>					
FROM	TO	LITHOLOGIC LOG	FROM	TO	LITHOLOGIC LOG
0	4	CLAY			
4	15	SANDY CLAY			
15	20	S/CLAY			
20	50	NO GRAVEL			
50	55	CLAY			
55	70	NO GRAVEL			
7 CONTRACTOR'S OR LANDOWNER'S CERTIFICATION: This water well was (1) constructed, (2) reconstructed, or (3) plugged under my jurisdiction and was completed on (mo/day/year) <u>10-13-89</u> and this record is true to the best of my knowledge and belief. Kansas Water Well Contractor's License No. <u>389</u> This Water Well Record was completed on (mo/day/yr) <u>10-26-89</u> under the business name of <u>PEISER WATER WELL SERV. INC.</u> by (signature) <u>Rudolph J. Peiser</u>					
INSTRUCTIONS: Use typewriter or ball point pen, PLEASE PRESS FIRMLY and PRINT clearly. Please fill in blanks, underline or circle the correct answers. Send top three copies to Kansas Department of Health and Environment, Division of Environment, Environmental Geology Section, Topeka, KS 66620. Send one to WATER WELL OWNER and retain one for your records.					