USE TYPEWRITER OR BALL POINT PEN-PRESS FIRMLY, PRINT CLEARLY.

WATER WELL RECORD
KSA 82a-1201-1215

Kansas Department of Health and Environment-Division of Environment
(Water well Contractors)
Topeka, Kansas 66620

1. Location of well:	County: Barton	Fraction: C SE 1/4 1/4 1/4	Section number: 34	Township number: T 20 S	Range number: R 12 E/W

2. Distance and direction from nearest town or city: 6 3 2 1/4 W 1/4 N Ellinwood
Street address of well location if in city:

3. Owner of well: Ron Ragan
R.R. or street:
City, state, zip code: Ellinwood, Ks.

4. Locate with "X" in section below: Sketch map:

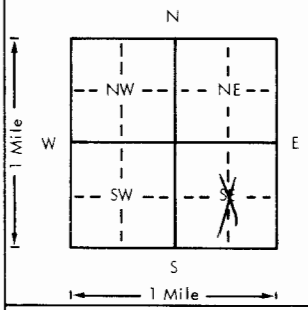

6. Bore hole dia. 7 7/8 in. Completion date 4-23-76
Well depth 115 ft.

7. __ Cable tool ✓ Rotary __ Driven __ Dug
__ Hollow rod __ Jetted __ Bored __ Reverse rotary

8. Use: __ Domestic __ Public supply __ Industry
__ Irrigation __ Air conditioning __ Stock
__ Lawn __ Oil field water __ Other

9. Casing: Material steel Height: Above or ~~below~~
Threaded ___ Welded ✓ Surface 15 in.
RMP ___ PVC ___ Weight ___ lbs./ft.
Dia. 16 in. to 16 ft. depth Wall Thickness: inches or
Dia. ___ in. to ___ ft. depth gage No. 1

5. Type and color of material	From	To
Sandy Top Soil	0	6
Fine Sand & Sandy Clay	6	46
Brown & White Clay	46	57
Sand & Gravel Clean Coarse loose	57	82
Brown Clay	82	84
Sand & Gravel Clean Coarse loose	84	103
Blue Gray Clay & Sand & Gravel	103	105
Sand & Gravel Clean Coarse	105	118
Blue & Brown Clay	118	125

(Use a second sheet if needed)

10. Screen: Manufacturer's name Dawson
Type steel Dia. 16
Slot ~~gauze~~ 3 1/16 Length 40
Set between 78 ft. and 115 ft.
___ ft. and ___ ft.
Gravel pack? ✓ Size range of material 1/8 to 3/8

11. Static water level: mo./day/yr.
32 ft. below land surface Date 1-3-76

12. Pumping level below land surfaces:
80 ft. after 1 hrs. pumping 200 g.p.m.
___ ft. after ___ hrs. pumping ___ g.p.m.
Estimated maximum yield 200 g.p.m.

13. Water sample submitted: mo./day/yr.
✓ Yes ___ No Date 1-4-76

14. Well head completion:
___ Pitless adapter ___ Inches above grade

15. Well grouted? ✓
With: ___ Neat cement ___ Bentonite ✓ Concrete
Depth: From 0 ft. to 20 ft.

16. Nearest source of possible contamination:
ft. 1/4 Direction E Type Septic
Well disinfected upon completion? ___ Yes ___ No

17. Pump: ___ Not installed
Manufacturer's name W.L.R.
Model number 5-CM-12 HP 60 Volts ___
Length of drop pipe 85 ft. capacity 1200 g.p.m.
Type:
___ Submersible ✓ Turbine
___ Jet ___ Reciprocating
___ Centrifugal ___ Other

18. Elevation:
Topography:
___ Hill
✓ Slope
___ Upland
___ Valley

19. Remarks:

20. Water well contractor's certification:
This well was drilled under my jurisdiction and this report is true to the best of my knowledge and belief.
Rosencrantz - Burns 134
Business name License No.
Address Great Bend, Ks.
Signed [signature] Date 4-23-76
Authorized representative

20 S 12 W T R 34 Sec C SE 1/4 1/4 1/4

Forward the white, blue and pink copies to the Department of Health and Environment

Form WWC-5

MI-1023