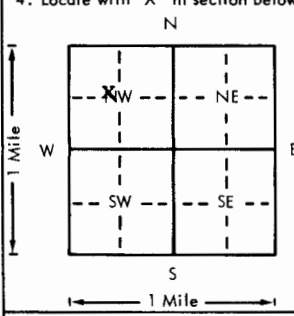


USE TYPEWRITER OR BALL
POINT PEN-PRESS FIRMLY,
PRINT CLEARLY.

WATER WELL RECORD
KSA 82a-1201-1215

Kansas Department of Health and
Environment-Division of Environment
(Water well Contractors)
Topeka, Kansas 66620

1. Location of well:		County Barton	Fraction 1/4 1/4CNW 1/4	Section number 1	Township number T 20 S R 13 E W
2. Distance and direction from nearest town or city: 2 1/2 miles east of Great Bend, KS 67530 Street address of well location if in city:				3. Owner of well: Dale Weller R.R. or street: Route 2 City, state, zip code: Great Bend, KS 67530	
4. Locate with "X" in section below:		Sketch map:		6. Bore hole dia. 24 in. Completion date 5-10-76 Well depth 80 ft.	
				7. ☐ Cable tool ☐ Rotary ☐ Driven ☐ Dug ☐ Hollow rod ☐ Jetted ☐ Bored ☒ Reverse rotary	
5. Type and color of material		From	To	8. Use: ☐ Domestic ☐ Public supply ☐ Industry ☒ Irrigation ☐ Air conditioning ☐ Stock ☐ Lawn ☐ Oil field water ☐ Other	
top soil		0	4	9. Casing: Material steel Height: Above or below Threaded ☐ Welded ☒ Surface 12 in. RMP ☐ PVC ☐ Weight 30.3 lbs./ft. Dia. 24 in. to 40 ft. depth Wall Thickness: inches or Dia. ☐ in. to ☐ ft. depth gage No. 7 ga.	
sand & gravel & thin clay streaks		4	30	10. Screen: Manufacturer's name Doer Type double-slot Dia. 16" ☒ Slot gauge 1/8 Length 40' Set between 40 ft. and 80 ft. ft. and ☐ ft.	
sand & gravel		30	80	Gravel pack? YES Size range of material 3/8-200	
				11. Static water level: ☐ mo./day/yr. 5'6" ft. below land surface Date 4-11-76	
				12. Pumping level below land surfaces: N/C ft. after ☐ hrs. pumping ☐ g.p.m. ft. after ☐ hrs. pumping ☐ g.p.m. Estimated maximum yield ☐ g.p.m.	
				13. Water sample submitted: ☐ mo./day/yr. ☐ Yes ☒ No Date ☐	
				14. Well head completion: ☐ Pitless adapter 12 inches above grade	
				15. Well grouted? YES With: ☒ Neat cement ☐ Bentonite ☐ Concrete Depth: From 0 ft. to 10 ft.	
				16. Nearest source of possible contamination: ft. ☐ Direction ☐ Type ☐ Well disinfected upon completion? ☐ Yes ☒ No	
				17. Pump: ☐ Not installed Manufacturer's name Berkeley Model number 1202M-4HP 80 Volts -- Length of drop pipe 50' ft. capacity 900 g.p.m. Type: ☐ Submersible ☒ Turbine ☐ Jet ☐ Reciprocating ☐ Centrifugal ☐ Other	
18. Elevation:		19. Remarks:		20. Water well contractor's certification: This well was drilled under my jurisdiction and this report is true to the best of my knowledge and belief. Clarke Well & Eq. Inc. 185 Business name Great Bend, KS 67530 License No. Address 5-24-76 Signed [Signature] Date 5-24-76 Authorized representative	

Forward the white, blue and pink copies to the Department of Health and Environment

Form WWC-5