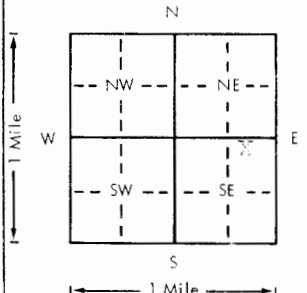


USE TYPEWRITER OR BALL
POINT PEN-PRESS FIRMLY,
PRINT CLEARLY.

WATER WELL RECORD
KSA 82a-1201-1215

Kansas Department of Health and
Environment-Division of Environment
(Water well Contractors)
Topeka, Kansas 66620

1. Location of well:		County Barton	Fraction nw 1/4 ne 1/4 se 1/4	Section number 4	Township number T 20 S R 13W	Range number E/W
2. Distance and direction from nearest town or city: Street address of well location if in city: Great Bend, Ks.				3. Owner of well: M.E. Marmie R.R. or street: 1809 Bdwy City, state, zip code: Great Bend, Ks.		
4. Locate with "X" in section below: 				Sketch map:		
5. Type and color of material				From	To	6. Bore hole dia. 5 1/2 in. Completion date 5-11-78 Well depth 65 ft.
						7. ☒ Cable tool ☒ Rotary ☐ Driven ☐ Dug ☐ Hollow rod ☐ Jetted ☐ Bored ☐ Reverse rotary
						8. Use: ☒ Domestic ☐ Public supply ☐ Industry ☐ Irrigation ☐ Air conditioning ☐ Stock ☐ Lawn ☐ Oil field water ☐ Other
						9. Casing: Material ☐ Height: Above ☒ Below Threaded ☐ Welded ☐ Surface 12 in. RMP ☐ PVC ☒ Weight .69 lbs./ft. Dia. 2 in. to 65 ft. depth Wall thickness: inches or Dia. ☐ in. to ☐ ft. depth Gauge No. sch 40
						10. Screen: Manufacturer's name Jetstream Type PVC Dia. 2" Slot/gauze 1/32" Length 20' Set between 455 ft. and 65 ft. Set between ☐ ft. and ☐ ft. Gravel pack? ☒ Size range of material 1/8-3/4"
						11. Static water level: 6 1/2 ft. below land surface Date 5-11-78 mo./day/yr.
						12. Pumping level below land surfaces: ____ ft. after ____ hrs. pumping ____ g.p.m. ____ ft. after ____ hrs. pumping ____ g.p.m. Estimated maximum yield 40 g.p.m.
						13. Water sample submitted: ____ mo./day/yr. Yes ☐ No ☒ Date ____
						14. Well head completion: ____ Pitless adapter 12 inches above grade
						15. Well grouted? ☒ With: ☒ Neat cement ☐ Bentonite ☐ Concrete Depth: From ____ ft. to 10 ft.
						16. Nearest source of possible contamination: ft. 55 Direction e Type sewer Well disinfected upon completion? ☒ Yes ☐ No
						17. Pump: ☒ Not installed Manufacturer's name ____ Model number ____ HP ____ Volts ____ Length of drop pipe ____ ft. capacity ____ g.p.m. Type: ☐ Submersible ☐ Turbine ☐ Jet ☐ Reciprocating ☐ Centrifugal ☐ Other
						20. Water well contractor's certification: This well was drilled under my jurisdiction and this report is true to the best of my knowledge and belief. Kellys Waterwell Ser 186 Business name Kellys License No. 10-1 Address R2 Great Bend, Ks. Signed Kelly Price Date 10-1-78 Authorized representative
18. Elevation:		19. Remarks:				
Topography: ☐ Hill ☒ Slope ☒ Upland ☒ Valley						

Forward the white, blue and pink copies to the Department of Health and Environment

Form WWC-5