USE TYPEWRITER OR BALL POINT PEN-PRESS FIRMLY, PRINT CLEARLY.

WATER WELL RECORD
KSA 82a-1201-1215

Kansas Department of Health and Environment-Division of Environment
(Water well Contractors)
Topeka, Kansas 66620

Robbins #1

1. Location of well:	County	Fraction	Section number	Township number	Range number
	Barton	SE 1/4 N ~~W~~ 1/4 N ~~W~~ 1/4	10	T 20 S	R 13 W E/W

2. Distance and direction from nearest town or city: 2 south 1 east Gt Bend.
Street address of well location if in city:

3. Owner of well: ~~Duke Drilling Co~~ I.D. Drilling
R.R. or street: Great Bend
City, state, zip code: Kansas

4. Locate with "X" in section below: Sketch map:

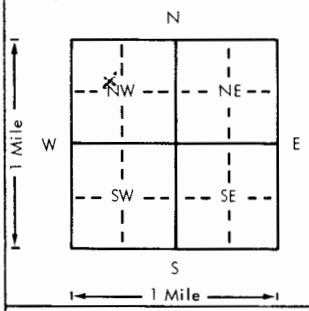

6. Bore hole dia. 5 in. Completion date
Well depth 40 ft. 2-9-78

7. __ Cable tool X Rotary __ Driven __ Dug
__ Hollow rod __ Jetted __ Bored __ Reverse rotary

8. Use: __ Domestic __ Public supply __ Industry
__ Irrigation __ Air conditioning __ Stock
__ Lawn X Oil field water __ Other

9. Casing: Material Plastic Height: (Above) or below
Threaded __ Welded X Surface 12 in.
RMP __ PVC X Weight 6 lbs./ft.
Dia. 2 in. to 40 ft. depth Wall Thickness: inches or
Dia. __ in. to __ ft. depth gage No. Sealed 40

5. Type and color of material	From	To
Clay	0	18
Sand	18	28
Gravel	28	40
(Use a second sheet if needed)		

10. Screen: Manufacturer's name Self made
Type PVC Dia. 2
Slot/gauze 8 Length 10
Set between 30 ft. and 40 ft.
ft. and ft.
Gravel pack? __ Size range of material

11. Static water level: mo./day/yr.
12 ft. below land surface Date 2-9-78

12. Pumping level below land surfaces:
ft. after hrs. pumping g.p.m.
ft. after hrs. pumping g.p.m.
Estimated maximum yield g.p.m.

13. Water sample submitted: mo./day/yr.
__ Yes X No Date

14. Well head completion:
__ Pitless adapter Inches above grade

15. Well grouted? Yes
With: __ Neat cement X Bentonite __ Concrete
Depth: From 0 ft. to 10 ft.

16. Nearest source of possible contamination:
ft. Direction Type
Well disinfected upon completion? __ Yes __ No

17. Pump: X Not installed
Manufacturer's name
Model number HP Volts
Length of drop pipe ft. capacity g.p.m.
Type:
__ Submersible __ Turbine
__ Jet __ Reciprocating
__ Centrifugal __ Other

18. Elevation:
Topography:
__ Hill
X Slope
__ Upland
__ Valley

19. Remarks:

20. Water well contractor's certification:
This well was drilled under my jurisdiction and this report is true to the best of my knowledge and belief.
Myers Water Well
Business name License No.
Address Gt Bend Ks
Signed A Myers 2-9-78 Date
Authorized representative

T 20 R 13 (W) E Sec 10 1/4 SE 1/4 1/4 1/4

Forward the white, blue and pink copies to the Department of Health and Environment

Form WWC-5

MI-1023