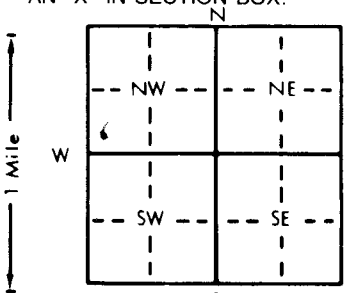


WAGNOR					WATER WELL RECORD		Form WWC-5		KSA 82a-1212																										
1 LOCATION OF WATER WELL:			Fraction		Section Number		Township Number		Range Number																										
County: <u>BARTON</u>			<u>S6 1/4</u> <u>S6 1/4</u> <u>N4 1/4</u>		<u>12</u>		T <u>20</u> S		R <u>13</u> <u>EW</u>																										
Distance and direction from nearest town or city street address of well if located within city? <u>GREAT BEND 1 1/2 E 1 1/2 S EASTSIDE</u>																																			
2 WATER WELL OWNER: <u>BOGELER BROTHERS, INC.</u> <u>H. WAGNOR, GREAT BEND, KS 67530</u>																																			
RR#, St. Address, Box # : <u>102 N. WALNUT</u> Board of Agriculture, Division of Water Resources																																			
City, State, ZIP Code : <u>HOLISINGTON, KS 67544</u> Application Number: <u>T84-226</u>																																			
3 LOCATE WELL'S LOCATION WITH AN "X" IN SECTION BOX:				4 DEPTH OF COMPLETED WELL: <u>65</u> ft. ELEVATION:																															
				Depth(s) Groundwater Encountered 1. <u>35</u> ft. 2. <u>35</u> ft. 3. <u>35</u> ft.																															
				WELL'S STATIC WATER LEVEL <u>25</u> ft. below land surface measured on mo/day/yr <u>4/16/84</u>																															
				WELL WATER TO BE USED AS: 5 Public water supply 8 Air conditioning 11 Injection well																															
				1 Domestic 3 Feedlot 6 Oil field water supply 9 Dewatering 12 Other (Specify below)																															
				2 Irrigation 4 Industrial 7 Lawn and garden only 10 Observation well																															
				Was a chemical/bacteriological sample submitted to Department? Yes <u> </u> No <u> </u> ; If yes, mo/day/yr sample was submitted																															
				Water Well Disinfected? Yes <u> </u> No <u> </u>																															
5 TYPE OF BLANK CASING USED:																																			
1 Steel 3 RMP (SR) 5 Wrought iron 8 Concrete tile CASING JOINTS: Glued <u>XX</u> Clamped <u> </u>																																			
2 PVC 4 ABS 6 Asbestos-Cement 9 Other (specify below) Welded <u> </u>																																			
7 Fiberglass Threaded <u> </u>																																			
Casing height above land surface <u>12</u> in., weight <u>2.65</u> lbs./ft. Wall thickness or gauge No. <u>2.14</u>																																			
TYPE OF SCREEN OR PERFORATION MATERIAL:																																			
1 Steel 3 Stainless steel 5 Fiberglass 8 RMP (SR) 10 Asbestos-cement																																			
2 Brass 4 Galvanized steel 6 Concrete tile 9 ABS 11 Other (specify) <u> </u>																																			
12 None used (open hole)																																			
SCREEN OR PERFORATION OPENINGS ARE: <u>1/8</u>																																			
1 Continuous slot 3 Mill slot 5 Gauzed wrapped 8 Saw cut 11 None (open hole)																																			
2 Louvered shutter 4 Key punched 6 Wire wrapped 9 Drilled holes																																			
7 Torch cut 10 Other (specify) <u> </u>																																			
SCREEN-PERFORATED INTERVALS: From <u>45</u> ft. to <u>65</u> ft., From <u> </u> ft. to <u> </u> ft.																																			
From <u> </u> ft. to <u> </u> ft., From <u> </u> ft. to <u> </u> ft.																																			
GRAVEL PACK INTERVALS: From <u>25</u> ft. to <u>65</u> ft., From <u> </u> ft. to <u> </u> ft.																																			
From <u> </u> ft. to <u> </u> ft., From <u> </u> ft. to <u> </u> ft.																																			
6 GROUT MATERIAL: 1 Neat cement 2 Cement grout 3 <u>Bentonite</u> 4 Other <u> </u>																																			
Grout Intervals: From <u>0</u> ft. to <u>10</u> ft., From <u> </u> ft. to <u> </u> ft., From <u> </u> ft. to <u> </u> ft.																																			
What is the nearest source of possible contamination: <u>NONE</u>																																			
1 Septic tank 4 Lateral lines 7 Pit privy 10 Livestock pens 14 Abandoned water well																																			
2 Sewer lines 5 Cess pool 8 Sewage lagoon 11 Fuel storage 15 Oil well/Gas well																																			
3 Watertight sewer lines 6 Seepage pit 9 Feedyard 12 Fertilizer storage 16 Other (specify below)																																			
13 Insecticide storage																																			
Direction from well? <u> </u> How many feet? <u> </u>																																			
<table><tr><td>FROM</td><td>TO</td><td>LITHOLOGIC LOG</td><td>FROM</td><td>TO</td><td>LITHOLOGIC LOG</td></tr><tr><td><u>0</u></td><td><u>13</u></td><td><u>SAND SOIL</u></td><td></td><td></td><td></td></tr><tr><td><u>13</u></td><td><u>35</u></td><td><u>FINE SAND</u></td><td></td><td></td><td></td></tr><tr><td><u>35</u></td><td><u>65</u></td><td><u>GRAVEL</u></td><td></td><td></td><td></td></tr>
7 CONTRACTOR'S OR LANDOWNER'S CERTIFICATION: This water well was (1) constructed, (2) reconstructed, or (3) plugged under my jurisdiction and was completed on (mo/day/year) <u>4/16/84</u> and this record is true to the best of my knowledge and belief. Kansas Water Well Contractor's License No. <u>3851</u> This Water Well Record was completed on (mo/day/yr) <u>4/25/85</u> under the business name of <u>PELSEA WATER WELL SERV INC</u> by (signature) <u>Paula A. Pelser</u>																																			
INSTRUCTIONS: Use typewriter or ball point pen, PLEASE PRESS FIRMLY and PRINT clearly. Please fill in blanks, underline or circle the correct answers. Send top three copies to Kansas Department of Health and Environment, Division of Environment, Environmental Geology Section, Topeka, KS 66620. Send one to WATER WELL OWNER and retain one for your records.																																			