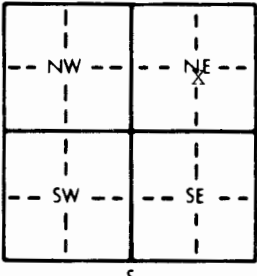
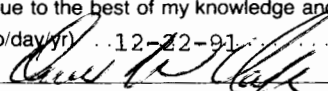


1 LOCATION OF WATER WELL:		Fraction Near the Center		Section Number	Township Number	Range Number
County: Barton		1/4 1/4 NE 1/4		15	T 20 S	R 13 E/W
Distance and direction from nearest town or city street address of well if located within city? Approximately 3 1/4 Miles South of Great Bend						
2 WATER WELL OWNER: Bill Madden						
RR#, St. Address, Box # : 616 n. Bismark				Board of Agriculture, Division of Water Resources		
City, State, ZIP Code : Ellinwood, KS 67526				Application Number: 39,292		
3 LOCATE WELL'S LOCATION WITH AN "X" IN SECTION BOX:		4 DEPTH OF COMPLETED WELL: 63 ft. ELEVATION: Unknown				
N 1 Mile W E S 		Depth(s) Groundwater Encountered 1. 31.5 ft. 2. ft. 3. ft.				
		WELL'S STATIC WATER LEVEL 31.5 ft. below land surface measured on mo/day/yr 12-13-91				
		Pump test data: Well water was not Ch'd ft. after hours pumping gpm				
		Est. Yield unknown gpm: Well water was ft. after hours pumping gpm				
		Bore Hole Diameter 24 in. to 62 ft., and in. to ft.				
WELL WATER TO BE USED AS:						
1 Domestic 3 Feedlot 6 Oil field water supply 8 Air conditioning 11 Injection well						
2 Irrigation 4 Industrial 7 Lawn and garden only 9 Dewatering 12 Other (Specify below)						
Was a chemical/bacteriological sample submitted to Department? Yes No X; If yes, mo/day/yr sample was submitted						
Water Well Disinfected? Yes No X						
5 TYPE OF BLANK CASING USED:						
1 Steel 3 RMP (SR) 5 Wrought iron 8 Concrete tile CASING JOINTS: Glued Clamped						
2 PVC 4 ABS 6 Asbestos-Cement 9 Other (specify below) Welded X						
7 Fiberglass Threaded						
Blank casing diameter 16 in. to 49 ft. Dia. in. to ft. Dia. in. to ft.						
Casing height above land surface 24 in. weight 36.87 lbs./ft. Wall thickness or gauge No. 219						
TYPE OF SCREEN OR PERFORATION MATERIAL:						
1 Steel 3 Stainless steel 5 Fiberglass 7 PVC 10 Asbestos-cement						
2 Brass 4 Galvanized steel 6 Concrete tile 8 RMP (SR) 11 Other (specify)						
9 ABS 12 None used (open hole)						
SCREEN OR PERFORATION OPENINGS ARE:						
1 Continuous slot 3 Mill slot 5 Gauzed wrapped 8 Saw cut 11 None (open hole)						
2 Louvered shutter 4 Key punched 6 Wire wrapped 9 Drilled holes						
7 Torch cut 10 Other (specify) bridge slot						
SCREEN-PERFORATED INTERVALS: From 49 ft. to 61 ft. From ft. to ft.						
From ft. to ft. From ft. to ft.						
GRAVEL PACK INTERVALS: From 20 ft. to 62 ft. From ft. to ft.						
From ft. to ft. From ft. to ft.						
6 GROUT MATERIAL: 1 Neat cement 2 Cement grout 3 Bentonite 4 Other						
Grout Intervals: From 0 ft. to 20 ft. From ft. to ft. From ft. to ft.						
What is the nearest source of possible contamination:						
1 Septic tank 4 Lateral lines 7 Pit privy 10 Livestock pens 14 Abandoned water well						
2 Sewer lines 5 Cess pool 8 Sewage lagoon 11 Fuel storage 15 Oil well/Gas well						
3 Watertight sewer lines 6 Seepage pit 9 Feedyard 12 Fertilizer storage 16 Other (specify below)						
13 Insecticide storage none Known						
Direction from well? How many feet?						
FROM TO		LITHOLOGIC LOG		FROM TO		PLUGGING INTERVALS
0	6	Topsoil, sandy				
6	23	clay, brown, Sandy				
23	28	Sand, fine				
28	30	Clay, brown and white				
30	37	Sand, fine, very fine				
37	42	Clay, brown				
42	61	Sand and gravel, fine, medium				
61	62	Clay and sand				
7 CONTRACTOR'S OR LANDOWNER'S CERTIFICATION: This water well was (1) constructed, (2) reconstructed, or (3) plugged under my jurisdiction and was completed on (mo/day/year) 12-13-91 and this record is true to the best of my knowledge and belief. Kansas Water Well Contractor's License No. 185 This Water Well Record was completed on (mo/day/yr) 12-22-91 under the business name of Clarke Well & Equipment, Inc. by (signature) 						
INSTRUCTIONS: Use typewriter or ball point pen. PLEASE PRESS FIRMLY and PRINT clearly. Please fill in blanks, underline or circle the correct answers. Send top three copies to Kansas Department of Health and Environment, Bureau of Water, Topeka, Kansas 66620-0001. Telephone: 913-296-5545. Send one to WATER WELL OWNER and retain one for your records.						

OFFICE USE ONLY

T

R

EW

SEC.

1/4

1/4

1/4