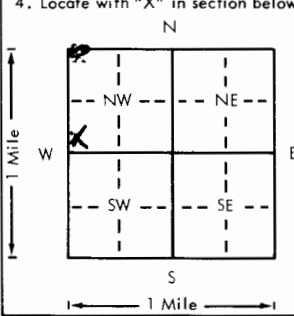


USE TYPEWRITER OR BALL
POINT PEN-PRESS FIRMLY,
PRINT CLEARLY.

WATER WELL RECORD
KSA 82a-1201-1215

Kansas Department of Health and
Environment-Division of Environment
(Water well Contractors)
Topeka, Kansas 66620

1. Location of well:		County Barton	Fraction SW 1/4 NW 1/4	Section number 16	Township number T 20 S	Range number R 13 E
2. Distance and direction from nearest town or city: 2 1/2 miles South of Great Bend, KS Street address of well location if in city:				3. Owner of well: Glenn Irick R.R. or street: Route 2 City, state, zip code: Great Bend, KS 67530		
4. Locate with "X" in section below:  Sketch map:				6. Bore hole dia. 9 in. Completion date 9-22-77 Well depth 80' ft.		
5. Type and color of material				7. ☐ Cable tool ☐ Rotary ☐ Driven ☐ Dug ☐ Hollow rod ☐ Jetted ☐ Bored ☒ Reverse rotary		
				8. Use: ☒ Domestic ☐ Public supply ☐ Industry ☐ Irrigation ☐ Air conditioning ☐ Stock ☐ Lawn ☐ Oil field water ☐ Other		
From To				9. Casing: Material styrene Height: Above or below Threaded ☐ Welded ☒ Surface 12 in. RMP ☐ PVC ☐ Weight 1.5 lbs./ft. Dia. 5 in. to 60 ft. depth Wall Thickness: inches or Dia. 5 in. to 60 ft. depth gage No. 200#		
				10. Screen: Manufacturer's name Jess & Lowell Type Styrene 200 Dia. 5" Slot/gauze 1/8 Length 20' Set between 60 ft. and 80 ft. Gravel pack? yes Size range of material 3/8-200		
Top soil & clay				0	8	11. Static water level: 12' 2" ft. below land surface Date 9-22-77
Soft black clay				8	13	12. Pumping level below land surfaces: N/C ____ ft. after ____ hrs. pumping ____ g.p.m. ____ ft. after ____ hrs. pumping ____ g.p.m. Estimated maximum yield ____ g.p.m.
Fine sand				13	22	13. Water sample submitted: ____ mo./day/yr. ____ Yes ☒ No Date ____
Blue clay				22	25	14. Well head completion: ____ Pitless adapter 1' 10" inches above grade
Fine sand & gravel				25	44	15. Well grouted? yes With: ☒ Neat cement ☐ Bentonite ☐ Concrete Depth: From 40 ft. to 50 ft.
Sand & gravel with clay streaks				44	52	16. Nearest source of possible contamination: FIELD ft. ____ Direction ____ Type ____ Well disinfected upon completion? ☒ Yes ____ No
Sand				52	58	17. Pump: ☒ Not installed Manufacturer's name ____ Model number ____ HP ____ Volts ____ Length of drop pipe ____ ft. capacity ____ g.p.m. Type: ____ Submersible ____ Turbine ____ Jet ____ Reciprocating ____ Centrifugal ____ Other
Sand & gravel				58	68	20. Water well contractor's certification: This well was drilled under my jurisdiction and this report is true to the best of my knowledge and belief. Clarke Well Eq., Inc. 185 Business name Address Great Bend, KS 67530 License No. Signed D.W. Clarke Date 9-24-77 Authorized representative
Blue clay				68	69	
Sand & gravel - Fine - Medium				69	80	
(Use a second sheet if needed)						
18. Elevation:		19. Remarks:				
Topography: ____ Hill ____ Slope ____ Upland ____ Valley						

Forward the white, blue and pink copies to the Department of Health and Environment

Form WWC-5