

1 LOCATION OF WATER WELL:	Fraction	Section Number	Township Number	Range Number
County: <u>Barton</u>	C $\frac{1}{4}$ SW $\frac{1}{4}$ $\frac{1}{4}$	18	T 20 S	R 13W E/W

Distance and direction from nearest town or city street address of well if located within city?


3 3/4 S of Great Bend, Kansas

2	WATER WELL OWNER:	May Harrison	Mohawk Drilling	Harrison #1
	RR#, St. Address, Box # :	Great Bend, Ks.	Box 1362	Board of Agriculture, Division of Water Resources
	City, State, ZIP Code :	67530	Great Bend, Kansas 67530	Application Number: Unknown

3 LOCATE WELL'S LOCATION WITH AN "X" IN SECTION BOX:

4 DEPTH OF COMPLETED WELL: 80 ft. ELEVATION: Unknown

Unknown

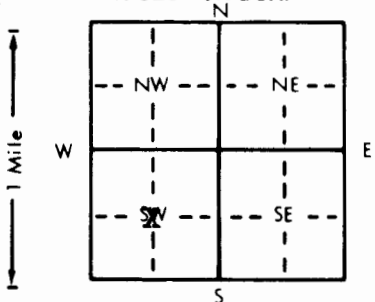

Depth(s) Groundwater Encountered 1. 18 ft. 2. _____ ft. 3. _____ ft.

WELL'S STATIC WATER LEVEL 18 ft. below land surface measured on mo/day/yr 4/9/85

Pump test data: Well water was _____ ft. after _____ hours pumping _____ gpm

Est. Yield 60 gpm: Well water was _____ ft. after _____ hours pumping _____ gpm

Bore Hole Diameter 8 in. to 80 ft., and _____ in. to _____ ft.

WELL WATER TO BE USED AS:

1 Domestic	3 Feedlot	6 <u>Oil field water supply</u>	9 Dewatering	11 Injection well
2 Irrigation	4 Industrial	7 Lawn and garden only	10 Observation well	12 Other (Specify below)

Was a chemical/bacteriological sample submitted to Department? Yes _____ No _____; If yes, mo/day/yr sample was submitted _____

Water Well Disinfected? Yes _____ No _____

5 TYPE OF BLANK CASING USED: 5 Wrought iron 8 Concrete tile CASING JOINTS: Glued Clamped
1 Steel 3 RMP (SR) 6 Asbestos-Cement 9 Other (specify below) Welded
2 PVC 4 ABS 7 Fiberglass Threaded
Blank casing diameter 5 in. to 60 ft., Dia in. to ft., Dia in. to ft.
Casing height above land surface 12 in. weight 2.8 lbs./ft. Wall thickness or gauge No. Sch. 40

TYPE OF SCREEN OR PERFORATION MATERIAL:			7. <u>PVC</u>	10 Asbestos-cement
1 Steel	3 Stainless steel	5 Fiberglass	8 <u>RMP</u> (SR)	11 Other (specify)
2 Brass	4 Galvanized steel	6 Concrete tile	9 ABS	12 None used (open hole)
SCREEN OR PERFORATION OPENINGS ARE:			5 Gauzed wrapped	8. <u>Saw cut</u>
1 Continuous slot	3 Mill slot	6 Wire wrapped	9 Drilled holes	11 None (open hole)
2 Louvered shutter	4 Key punched	7 Torch cut	10 Other (specify)	
SCREEN-PERFORATED INTERVALS:			From <u>60</u> ft. to <u>80</u> ft., From ft. to ft.	
			From ft. to ft., From ft. to ft.	
GRAVEL PACK INTERVALS:			From <u>10</u> ft. to <u>80</u> ft., From ft. to ft.	
			From ft. to ft. From ft. to ft.	

6 GROUT MATERIAL:		1 Neat cement		2 Cement grout		3 Bentonite		4 Other	
Grout Intervals:		From 0 ft. to 10 ft.		From		ft. to		ft. to	
What is the nearest source of possible contamination:									
1 Septic tank		4 Lateral lines		7 Pit privy		10 Livestock pens		14 Abandoned water well	
2 Sewer lines		5 Cess pool		8 Sewage lagoon		11 Fuel storage		15 Oil well/Gas well	
3 Watertight sewer lines		6 Seepage pit		9 Feedyard		12 Fertilizer storage		16 Other (specify below)	
Direction from well?		South				How many feet?		60	

[illegible]

7 CONTRACTOR'S OR LANDOWNER'S CERTIFICATION: This water well was (1) constructed, (2) reconstructed, or (3) plugged under my jurisdiction and was completed on (mo/day/year) 4/9/85 and this record is true to the best of my knowledge and belief. Kansas Water Well Contractor's License No. 186 This Water Well Record was completed on (mo/day/yr) 5/6/85 under the business name of Kelly's Water Well Service by (signature) [Signature]

INSTRUCTIONS: Use typewriter or ball point pen, **PLEASE PRESS FIRMLY** and **PRINT** clearly. Please fill in blanks, underline or circle the correct answers. Send top three copies to Kansas Department of Health and Environment, Division of Environment, Environmental Geology Section, Topeka, KS 66620. Send one to WATER WELL OWNER and retain one for your records.