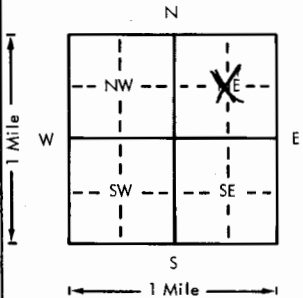


USE TYPEWRITER OR BALL
POINT PEN-PRESS FIRMLY,
PRINT CLEARLY.

WATER WELL RECORD
KSA 82a-1201-1215

Kansas Department of Health and
Environment-Division of Environment
(Water well Contractors)
Topeka, Kansas 66620

1. Location of well:		County Barton	Fraction 1/4 1/4 CNE 1/4	Section number 23	Township number T 20 S R 13 W	Range number 13 W
2. Distance and direction from nearest town or city: 35.2 E		3. Owner of well: Ralph Phillips R.R. or street: 217 Frey City, state, zip code: Great Bend, KS				
Street address of well location if in city: Great Bend, KS						
4. Locate with "X" in section below:		Sketch map:				6. Bore hole dia. 30 in. Completion date Well depth 65 ft. 3-26-77
						7. ☐ Cable tool ☐ Rotary ☐ Driven ☐ Dug ☐ Hollow rod ☐ Jetted ☐ Bored ☒ Reverse rotary
5. Type and color of material		From	To	8. Use: ☐ Domestic ☐ Public supply ☐ Industry ☒ Irrigation ☐ Air conditioning ☐ Stock ☐ Lawn ☐ Oil field water ☐ Other		
Top Soil - Clay		0	28	9. Casing: Material Steel Height: Above or below Threaded ☐ Welded ☒ Surface 12 in. RMP ☐ PVC ☐ Weight ☐ lbs./ft. Dia. 16 in. to 45 ft. depth Wall Thickness: inches or Dia. ☐ in. to ☐ ft. depth Gage No. 3/16"		
Sand - Gravel		28	65	10. Screen: Manufacturer's name Doerr Type steel Dia. 16 Slot/gauze 1/8" Length 20' Set between 45 ft. and 65 ft. Gravel pack? ☒ Size range of material 1/8-3/4"		
				11. Static water level: 25 ft. below land surface Date 3-26-77		
				12. Pumping level below land surfaces: ft. after ☐ hrs. pumping ☐ g.p.m. 46 ft. after 4 hrs. pumping 1000 g.p.m. Estimated maximum yield 1200 g.p.m.		
				13. Water sample submitted: ☐ Yes ☒ No Date		
				14. Well head completion: ☐ Pitless adapter 12 inches above grade		
				15. Well grouted? ☒ With: ☒ Neat cement ☐ Bentonite ☐ Concrete Depth: From 0 ft. to 10 ft.		
				16. Nearest source of possible contamination: NONE ft. Direction Type Well disinfected upon completion? ☐ Yes ☐ No		
				17. Pump: Not installed Manufacturer's name Grundfos Model number 4125 HP 60 Volts 480 Length of drop pipe 60 ft. capacity 800 g.p.m. Type: ☐ Submersible ☒ Turbine ☐ Jet ☐ Reciprocating ☐ Centrifugal ☐ Other		
18. Elevation:		19. Remarks: 1965				
Topography: ☐ Hill ☒ Slope ☒ Upland ☐ Valley		20. Water well contractor's certification: This well was drilled under my jurisdiction and this report is true to the best of my knowledge and belief. 186 Kelly's Water Well Ser Business name R2 Great Bend, KS License No. Address Kelly Price Date 7-5-77 Signed Kelly Price Authorized representative				