USE TYPEWRITER OR BALL POINT PEN-PRESS FIRMLY, PRINT CLEARLY.

T R EW sec 1/4 1/4 1/4 No.

WATER WELL RECORD
KSA 82a-1201-1215

Kansas State Dept. Of Health
(Water Well Contractors)
Forbes-Bldg. 740
Topeka, Kansas 66620

1 Location of well:	County	Township name	Fraction	Section number	Town number	Range number
	Barton	South Bend	CW½ SW¼	27	20 S	13 W

Distance and direction from nearest town or city: 5 S.

Street address of well location if in city: Great Bend, KS

3 Owner of well: Dwaine Grubb

Address: R 2 Great Bend, Kans

Locate with "X" in section below:

Sketch map:

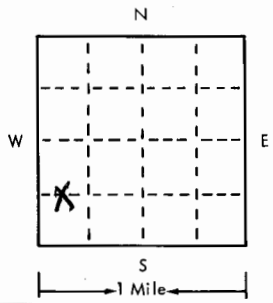

4 Well depth: 60 ft. Date of completion 5-10-75
Well diameter 8 in.

5 ☐ Cable tool ☒ Rotary ☐ Driven ☐ Dug
☐ Hollow rod ☐ Jetted ☐ Bored ☐ Reverse rotary

6 Use: ☒ Domestic ☐ Public supply ☐ Industry
☐ Irrigation ☐ Air conditioning ☐ Commercial
☐ Test well ☐ _____

7 Casing: Material PVC
Threaded ☐ Welded ☐
Diam. 5 in. to 60 ft. depth
___ in. to ___ ft. depth
Height: above/below Surface 12" in.
Weight ___ lbs./ft.
Drive shoe? ☐ Yes ☒ No

2

Type and color of material	From	To
Top Soil-Clay	0	15
Sand-Gravel	15	30
Clay	30	36
Sand-Gravel	36	60
(use a second sheet if needed)		

8 Screen:
Manufacturer MPI
Type PVC Dia. 5"
Slot/gauze 1/8 Length 20'
Set between 40 ft. and 60 ft.
Fittings:
Gravel pack ☒ Yes ☐ No Size range of material 1/8-3/4"

9 Static water level:
18 ft. below land surface Date 5-10-75

10 Pumping level below land surfaces:
___ ft. after ___ hrs. pumping ___ g.p.m.
___ ft. after ___ hrs. pumping ___ g.p.m.
Estimated maximum yield 100 g.p.m.

11 Water sample submitted:
☐ Yes ☒ No Date ___

12 Well head completion:
☐ Pitless adapter ☒ Inches above grade 12"

13 Well grouted? ☒ Yes ☐ No
☒ Neat cement ☐ Bentonite ☐ _____
Depth: From ___ ft. to ___ ft.

14 Nearest source of possible contamination:
ft. 100 Direction S Type Septic Tank
Well disinfected upon completion? ☒ Yes ☐ No

15 Pump: ☒ Not installed
Manufacturer's name _____
Model number _____ HP _____ Volts _____
Length of drop pipe _____ ft. capacity _____ g.m.p.
Type:
☐ Submersible ☐ Turbine
☐ Jet ☐ Reciprocating
☐ Certrifugal ☐ Other

16 Remarks: elevation

Topography:
☐ Hill
☐ Slope
☐ Upland
☒ Valley

17 Water well contractor's certification:
This well was drilled under my jurisdiction and this report is true to the best of my knowledge and belief.
Business name Kelly's Water Well Ser License No. 186
Address R 2 Great Bend KS
Signed Kelly Price Date 5-20-75
Authorized representative

Forward the white, blue and pink copies to the Kansas State Dept. Of Health.

Form WWC-5