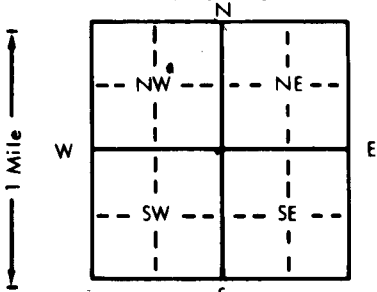


H155 #1

WATER WELL RECORD Form WWC-5 KSA 82a-1212

1 LOCATION OF WATER WELL:		Fraction	Section Number	Township Number	Range Number
County: <u>BARTON</u>		<u>SW</u> $\frac{1}{4}$ <u>NE</u> $\frac{1}{4}$ <u>NW</u> $\frac{1}{4}$	<u>34</u>	T <u>20</u> S	R <u>13</u> E <u>10</u>
Distance and direction from nearest town or city street address of well if located within city? <u>GREAT BEND 35 1/4 E SOUTHSIDE</u>					
2 WATER WELL OWNER: <u>D.R. LACICK OIL CO. INC.</u> <u>EDWIN HISS</u> RR#, St. Address, Box #: <u>2215 BROADWAY SUITE 400</u> <u>RT 3</u> City, State, ZIP Code: <u>WICHITA, KS 67202</u> <u>GREAT BEND, KS 67530</u> Board of Agriculture, Division of Water Resources Application Number: <u>T-83-105</u>					
3 LOCATE WELL'S LOCATION WITH AN "X" IN SECTION BOX:		4 DEPTH OF COMPLETED WELL: <u>60</u> ft. ELEVATION:			
		Depth(s) Groundwater Encountered 1. <u>40</u> ft. 2. _____ ft. 3. _____ ft. WELL'S STATIC WATER LEVEL <u>21</u> ft. below land surface measured on mo/day/yr <u>3-8-83</u> Pump test data: Well water was _____ ft. after _____ hours pumping _____ gpm Est. Yield _____ gpm; Well water was _____ ft. after _____ hours pumping _____ gpm Bore Hole Diameter: <u>7 1/8</u> in. to <u>60</u> ft. and _____ in. to _____ ft. WELL WATER TO BE USED AS: 5 Public water supply 8 Air conditioning 11 Injection well 1 Domestic 3 Feedlot 6 <u>Oil field water supply</u> 9 Dewatering 12 Other (Specify below) 2 Irrigation 4 Industrial 7 Lawn and garden only 10 Observation well Was a chemical/bacteriological sample submitted to Department? Yes _____ No _____; If yes, mo/day/yr sample was submitted _____ Water Well Disinfected? Yes _____ No _____			
5 TYPE OF BLANK CASING USED:					
1 Steel		3 RMP (SR)	5 Wrought iron	8 Concrete tile	CASING JOINTS: Glued <u>KY</u> Clamped _____
2 <u>PVC</u>		4 <u>ABS</u>	6 Asbestos-Cement	9 Other (specify below)	Welded _____
Blank casing diameter <u>5</u> in. to <u>40</u> ft. Dia _____ in. to _____ ft. Dia _____ in. to _____ ft.		7 Fiberglass	Threaded _____		
Casing height above land surface <u>12</u> in., weight <u>2.65</u> lbs./ft. Wall thickness or gauge No. <u>214</u>					
TYPE OF SCREEN OR PERFORATION MATERIAL:					
1 Steel		3 Stainless steel	5 Fiberglass	7 <u>PVC</u>	10 Asbestos-cement
2 Brass		4 Galvanized steel	6 Concrete tile	8 <u>RMP (SR)</u>	11 Other (specify) _____
SCREEN OR PERFORATION OPENINGS ARE: <u>1/8</u>		5 Gauzed wrapped	8 <u>Saw cut</u>	11 None (open hole)	
1 Continuous slot		3 Mill slot	6 Wire wrapped	9 Drilled holes	
2 Louvered shutter		4 Key punched	7 Torch cut	10 Other (specify) _____	
SCREEN-PERFORATED INTERVALS: From <u>40</u> ft. to <u>60</u> ft. From _____ ft. to _____ ft. From _____ ft. to _____ ft.					
GRAVEL PACK INTERVALS: From <u>30</u> ft. to <u>60</u> ft. From _____ ft. to _____ ft. From _____ ft. to _____ ft.					
6 GROUT MATERIAL: 1 Neat cement 2 Cement grout 3 <u>Bentonite</u> 4 Other _____					
Grout Intervals: From <u>0</u> ft. to <u>10</u> ft. From _____ ft. to _____ ft. From _____ ft. to _____ ft.					
What is the nearest source of possible contamination: <u>NONE</u>					
1 Septic tank		4 Lateral lines	7 Pit privy	10 Livestock pens	14 Abandoned water well
2 Sewer lines		5 Cess pool	8 Sewage lagoon	11 Fuel storage	15 Oil well/Gas well
3 Watertight sewer lines		6 Seepage pit	9 Feedyard	12 Fertilizer storage	16 Other (specify below)
Direction from well?		How many feet?			
FROM	TO	LITHOLOGIC LOG	FROM	TO	LITHOLOGIC LOG
<u>0</u>	<u>4</u>	<u>SOIL</u>			
<u>4</u>	<u>20</u>	<u>SANDY CLAY</u>			
<u>20</u>	<u>23</u>	<u>CLAY</u>			
<u>23</u>	<u>40</u>	<u>FINE SAND</u>			
<u>40</u>	<u>60</u>	<u>GRAVEL</u>			
7 CONTRACTOR'S OR LANDOWNER'S CERTIFICATION: This water well was (1) <u>constructed</u> , (2) reconstructed, or (3) plugged under my jurisdiction and was completed on (mo/day/year) <u>3-8-83</u> and this record is true to the best of my knowledge and belief. Kansas Water Well Contractor's License No. <u>389</u> This Water Well Record was completed on (mo/day/yr) <u>3-17-83</u> under the business name of <u>REISER WATER WELL SERV. INC.</u> by (signature) <u>Rudolph J. Reiser</u> INSTRUCTIONS: Use typewriter or ball point pen, PLEASE PRESS FIRMLY and PRINT clearly. Please fill in blanks, underline or circle the correct answers. Send top three copies to Kansas Department of Health and Environment, Division of Environment, Environmental Geology Section, Topeka, KS 66620. Send one to WATER WELL OWNER and retain one for your records.					