

1 LOCATION OF WATER WELL:		Fraction	Section Number	Township Number	Range Number
County:	Barton	SW 1/4 SW 1/4 SW 1/4	32	T 20 S	R 14 E/W


1 LOCATION OF WATER WELL:		Fraction	Section Number			Township Number		Range Number	
County:	Barton	SW 1/4 SW 1/4 SW 1/4	32			T 20 S		R 14 E	

Distance and direction from nearest town or city street address of well if located within city?

Pawnee Rock, Ks. 4 1/8 miles east.

2	WATER WELL OWNER:	Bev Nichols	Board of Agriculture, Division of Water Resources
	RR#, St. Address, Box # :	674 SW 65 Ave	
	City, State, ZIP Code :	Pawnee Rock, Ks. 67567	Application Number: BTWW0373

3 LOCATE WELL'S LOCATION WITH AN "X" IN SECTION BOX: 4 DEPTH OF COMPLETED WELL..... 72..... ft. ELEVATION:

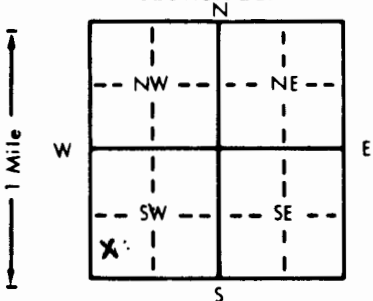

Depth(s) Groundwater Encountered 1. ft. 2. ft. 3. ft. ft.

WELL'S STATIC WATER LEVEL . . . 17 . . . ft. below land surface measured on mo/day/yr . . . 5-10-96 . . .

Pump test data: Well water was ft. after hours pumping gpm

Est. Yield na gpm: Well water was ft. after hours pumping gpm

Bore Hole Diameter. . . . 10 . in. to . . . 72 . . . ft., and in. to ft.

WELL WATER TO BE USED AS:

1 Domestic	3 Feedlot	6 Oil field water supply	9 Dewatering	12 Other (Specify below)
2 Irrigation	4 Industrial	7 Lawn and garden only	10 Monitoring well	

Was a chemical/bacteriological sample submitted to Department? Yes No ☒; If yes, mo/day/yr sample was submitted

Water Well Disinfected? Yes hth No

5	TYPE OF BLANK CASING USED:		5 Wrought iron	8 Concrete tile	CASING JOINTS: Glued . . X . . Clamped Welded Threaded
	1 Steel	3 RMP (SR)	6 Asbestos-Cement	9 Other (specify below)	
	2 PVC	4 ABS	7 Fiberglass		

Blank casing diameter 5 in. to 60 ft. Dia in. to ft. Dia in. to ft.
Casing height above land surface 2' in. weight 258 lbs./ft. Wall thickness or gauge No.

TYPE OF SCREEN OR PERFORATION MATERIAL:			7_PVC_	10 Asbestos-cement
1 Steel	3 Stainless steel	5 Fiberglass	8 RMP (SR)	11 Other (specify)
2 Brass	4 Galvanized steel	6 Concrete tile	9 ABS	12 None used (open hole)

SCREEN OR PERFORATION OPENINGS ARE:

1 Continuous slot	3 Mill slot	5 Gauzed wrapped	8 Saw cut	11 None (open hole)
2 Louvered shutter	4 Key punched	6 Wire wrapped	9 Drilled holes	
		7 Torch cut	10 Other (specify) _____	

SCREEN-PERFORATED INTERVALS: From 60 ft. to 72 ft., From ft. to ft.
From ft. to ft., From ft. to ft.
GRAVEL PACK INTERVALS: From 72 ft. to 20 ft., From ft. to ft.

		From		ft. to		ft., From		ft. to		ft.	
6	GROUT MATERIAL:	1 Neat cement		2 Cement grout		3 Bentonite		4 Other	hole plug		
	Grout Intervals:	From 0	ft. to 20	ft.	From	ft. to	ft.	From	ft. to	ft.	

What is the nearest source of possible contamination:

1 <u>Septic tank</u>	4 Lateral lines	7 Pit privy	10 Livestock pens	14 Abandoned water well
2 <u>Sewer lines</u>	5 Cess pool	8 Sewage lagoon	11 Fuel storage	15 Oil well/Gas well
			12 Fertilizer storage	16 Other (specify below)

3 Watertight sewer lines 6 Seepage pit 9 Feedyard 13 Insecticide storage
 Direction from well? east How many feet? 100'

INSTRUCTIONS: Use typewriter or ball point pen. PLEASE PRESS FIRMLY and PRINT clearly. Please fill in blanks, underline or circle the correct answers. Send top three copies to Kansas Department of Health and Environment, Bureau of Water, Topeka, Kansas 66620-0001. Telephone: 913-296-5545. Send one to WATER WELL OWNER and retain one for your records.