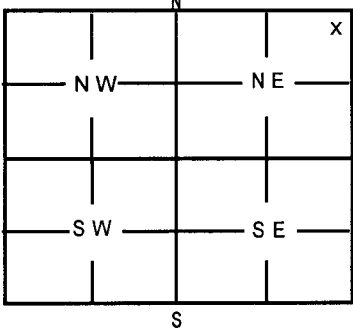
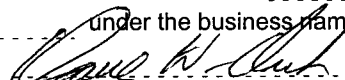


1 LOCATION OF WATER WELL: County: Barton	Fraction NE 1/4 NE 1/4 NE 1/4	Section Number 36	Township Number T 20 S	Range Number R 14 E																								
Distance and direction from nearest town or city street address of well if located within city? Approximately 6 miles south of Great Bend																												
2 WATER WELL OWNER: Phillips Petroleum Company RR#, St. Address, Box # P.O. Box 358 City, State, ZIP Code Borger, TX 79008 Board of Agriculture, Division of Water Resources Application Number:																												
3 MARK WELL'S LOCATION WITH AN "X" IN SECTION BOX: 	4 DEPTH OF WELL 63 ft. WELL'S STATIC WATER LEVEL 15 ft. WELL WAS USED AS: <table style="width:100%;"><tr><td>1 Domestic</td><td>5 Public Water Supply</td><td>9 Dewatering</td></tr><tr><td>2 Irrigation</td><td>6 Oil Field Water Supply</td><td>10 Monitoring Well</td></tr><tr><td>3 Feedlot</td><td>7 Domestic (Lawn & Garden)</td><td>11 Injection Well</td></tr><tr><td>4 Industrial</td><td>8 Air Conditioning</td><td>12 Other</td></tr></table> Was a chemical / bacteriological sample submitted to Department? Yes ☐ No ☒ If yes, mo/day/yr sample was submitted _____ Water Well Disinfected: Yes ☒ No ☐				1 Domestic	5 Public Water Supply	9 Dewatering	2 Irrigation	6 Oil Field Water Supply	10 Monitoring Well	3 Feedlot	7 Domestic (Lawn & Garden)	11 Injection Well	4 Industrial	8 Air Conditioning	12 Other												
1 Domestic	5 Public Water Supply	9 Dewatering																										
2 Irrigation	6 Oil Field Water Supply	10 Monitoring Well																										
3 Feedlot	7 Domestic (Lawn & Garden)	11 Injection Well																										
4 Industrial	8 Air Conditioning	12 Other																										
5 TYPE OF BLANK CASING USED: <table style="width:100%;"><tr><td>1 Steel</td><td>3 RMP (SR)</td><td>5 Wrought</td><td>7 Fiberglass</td><td>9 Other (Specify below)</td></tr><tr><td>2 PVC</td><td>4 ABS</td><td>6 Asbestos-Cement</td><td>8 Concrete Tile</td><td></td></tr></table> Blank casing diameter 5 in. Was casing pulled? Yes ☐ No ☐ Casing height above or below land surface 48 in. If yes, how much Cut off					1 Steel	3 RMP (SR)	5 Wrought	7 Fiberglass	9 Other (Specify below)	2 PVC	4 ABS	6 Asbestos-Cement	8 Concrete Tile															
1 Steel	3 RMP (SR)	5 Wrought	7 Fiberglass	9 Other (Specify below)																								
2 PVC	4 ABS	6 Asbestos-Cement	8 Concrete Tile																									
6 GROUT PLUG MATERIAL: 1 Neat Cement 2 Cement grout 3 Bentonite 4 Other Bentonite Holeplug Grout Plug Intervals: From _____ ft. to _____ ft., From _____ ft. to _____ ft. From 16 ft. to 4 ft. What is the nearest source of possible contamination: <table style="width:100%;"><tr><td>1 Septic tank</td><td>6 Seepage pit</td><td>11 Fuel storage</td><td>16 Other (specify below)</td></tr><tr><td>2 Sewer lines</td><td>7 Pit privy</td><td>12 Fertilizer storage</td><td>None known</td></tr><tr><td>3 Watertight sewer lines</td><td>8 Sewage lagoon</td><td>13 Insecticide storage</td><td></td></tr><tr><td>4 Lateral lines</td><td>9 Feedyard</td><td>14 Abandoned water well</td><td></td></tr><tr><td>5 Cess Pool</td><td>10 Livestock pens</td><td>15 Oil well/Gas well</td><td></td></tr></table> Direction from well? _____ How many feet? _____					1 Septic tank	6 Seepage pit	11 Fuel storage	16 Other (specify below)	2 Sewer lines	7 Pit privy	12 Fertilizer storage	None known	3 Watertight sewer lines	8 Sewage lagoon	13 Insecticide storage		4 Lateral lines	9 Feedyard	14 Abandoned water well		5 Cess Pool	10 Livestock pens	15 Oil well/Gas well					
1 Septic tank	6 Seepage pit	11 Fuel storage	16 Other (specify below)																									
2 Sewer lines	7 Pit privy	12 Fertilizer storage	None known																									
3 Watertight sewer lines	8 Sewage lagoon	13 Insecticide storage																										
4 Lateral lines	9 Feedyard	14 Abandoned water well																										
5 Cess Pool	10 Livestock pens	15 Oil well/Gas well																										
<table border="1" style="width:100%; border-collapse: collapse;"><thead><tr><th style="width:15%;">FROM</th><th style="width:15%;">TO</th><th style="width:70%;">PLUGGING MATERIALS</th></tr></thead><tbody><tr><td>63</td><td>16</td><td>Chlorinated Sand</td></tr><tr><td>16</td><td>4</td><td>Bentonite Holeplug</td></tr><tr><td>4</td><td>0</td><td>Compacted Topsoil</td></tr><tr><td> </td><td> </td><td> </td></tr><tr><td> </td><td> </td><td> </td></tr><tr><td> </td><td> </td><td> </td></tr><tr><td> </td><td> </td><td> </td></tr></tbody></table>					FROM	TO	PLUGGING MATERIALS	63	16	Chlorinated Sand	16	4	Bentonite Holeplug	4	0	Compacted Topsoil												
FROM	TO	PLUGGING MATERIALS																										
63	16	Chlorinated Sand																										
16	4	Bentonite Holeplug																										
4	0	Compacted Topsoil																										
7 CONTRACTOR'S OR LANDOWNER'S CERTIFICATION: This water well was plugged under my jurisdiction and was completed on (mo/day/year) 6-15-00 and this record is true to the best of my knowledge and belief. Kansas Water Well Contractor's License No. 185 This Water Well Record was completed on (mo/day/year) 7-6-00 under the business name of Clarke Well & Equipment, Inc. by (signature) 																												
INSTRUCTIONS: Use typewriter or ball point pen. <u>Please press firmly</u> and <u>print</u> clearly. Please fill in blanks, underline or circle the correct answers. Send top three copies to Kansas Department of Health & Environment, Bureau of Water, Topeka, Kansas 66620-0001. Telephone: 785/296-3565. Send one to Water Well Owner and retain one for your records.																												