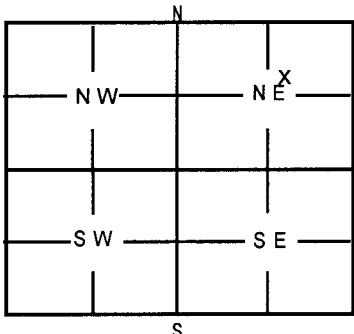
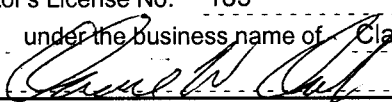


1 LOCATION OF WATER WELL: County: Barton	Fraction SW 1/4 NE 1/4 NE 1/4	Section 36	Number	Township T 20 S	Number R 14 E	Range W																											
Distance and direction from nearest town or city street address of well if located within city? Approximately 6 1/4 miles south and 1/4 mile west of Great Bend																																	
2 WATER WELL OWNER: Phillips Petroleum Company RR#, St. Address, Box # P.O. Box 358 City, State, ZIP Code Borger, TX 79008 Board of Agriculture, Division of Water Resources Application Number:																																	
3 MARK WELL'S LOCATION WITH AN "X" IN SECTION BOX: 		4 DEPTH OF WELL 63.5 ft. WELL'S STATIC WATER LEVEL 15.6 ft. WELL WAS USED AS: <table style="width:100%;"><tr><td>1 Domestic</td><td>5 Public Water Supply</td><td>9 Dewatering</td></tr><tr><td>2 Irrigation</td><td>6 Oil Field Water Supply</td><td>10 Monitoring Well</td></tr><tr><td>3 Feedlot</td><td>7 Domestic (Lawn & Garden)</td><td>11 Injection Well</td></tr><tr><td>4 Industrial</td><td>8 Air Conditioning</td><td>12 Other <u>Observation Well</u></td></tr></table> Was a chemical / bacteriological sample submitted to Department? Yes ☐ No ☒ If yes, mo/day/yr sample was submitted _____ Water Well Disinfected: Yes ☒ No ☐					1 Domestic	5 Public Water Supply	9 Dewatering	2 Irrigation	6 Oil Field Water Supply	10 Monitoring Well	3 Feedlot	7 Domestic (Lawn & Garden)	11 Injection Well	4 Industrial	8 Air Conditioning	12 Other <u>Observation Well</u>															
1 Domestic	5 Public Water Supply	9 Dewatering																															
2 Irrigation	6 Oil Field Water Supply	10 Monitoring Well																															
3 Feedlot	7 Domestic (Lawn & Garden)	11 Injection Well																															
4 Industrial	8 Air Conditioning	12 Other <u>Observation Well</u>																															
5 TYPE OF BLANK CASING USED: <table style="width:100%;"><tr><td>1 Steel</td><td>3 RMP (SR)</td><td>5 Wrought</td><td>7 Fiberglass</td><td>9 Other (Specify below)</td></tr><tr><td><u>2 PVC</u></td><td>4 ABS</td><td>6 Asbestos-Cement</td><td>8 Concrete Tile</td><td></td></tr></table> Blank casing diameter 2 in. Was casing pulled? Yes ☐ No ☐ Casing height above or <u>below</u> land surface 48 in. If yes, how much Cut off _____							1 Steel	3 RMP (SR)	5 Wrought	7 Fiberglass	9 Other (Specify below)	<u>2 PVC</u>	4 ABS	6 Asbestos-Cement	8 Concrete Tile																		
1 Steel	3 RMP (SR)	5 Wrought	7 Fiberglass	9 Other (Specify below)																													
<u>2 PVC</u>	4 ABS	6 Asbestos-Cement	8 Concrete Tile																														
6 GROUT PLUG MATERIAL: <table style="width:100%;"><tr><td>1 Neat Cement</td><td>2 Cement grout</td><td>3 Bentonite</td><td>4 Other <u>Bentonite Holeplug</u></td></tr></table> Grout Plug Intervals: From _____ ft. to _____ ft., From _____ ft. to _____ ft. From 30 ft. to 4 ft. What is the nearest source of possible contamination: <table style="width:100%;"><tr><td>1 Septic tank</td><td>6 Seepage pit</td><td>11 Fuel storage</td><td>16 Other (specify below)</td></tr><tr><td>2 Sewer lines</td><td>7 Pit privy</td><td>12 Fertilizer storage</td><td><u>None known</u></td></tr><tr><td>3 Watertight sewer lines</td><td>8 Sewage lagoon</td><td>13 Insecticide storage</td><td></td></tr><tr><td>4 Lateral lines</td><td>9 Feedyard</td><td>14 Abandoned water well</td><td></td></tr><tr><td>5 Cess Pool</td><td>10 Livestock pens</td><td>15 Oil well/Gas well</td><td></td></tr></table> Direction from well? _____ How many feet? _____							1 Neat Cement	2 Cement grout	3 Bentonite	4 Other <u>Bentonite Holeplug</u>	1 Septic tank	6 Seepage pit	11 Fuel storage	16 Other (specify below)	2 Sewer lines	7 Pit privy	12 Fertilizer storage	<u>None known</u>	3 Watertight sewer lines	8 Sewage lagoon	13 Insecticide storage		4 Lateral lines	9 Feedyard	14 Abandoned water well		5 Cess Pool	10 Livestock pens	15 Oil well/Gas well				
1 Neat Cement	2 Cement grout	3 Bentonite	4 Other <u>Bentonite Holeplug</u>																														
1 Septic tank	6 Seepage pit	11 Fuel storage	16 Other (specify below)																														
2 Sewer lines	7 Pit privy	12 Fertilizer storage	<u>None known</u>																														
3 Watertight sewer lines	8 Sewage lagoon	13 Insecticide storage																															
4 Lateral lines	9 Feedyard	14 Abandoned water well																															
5 Cess Pool	10 Livestock pens	15 Oil well/Gas well																															
<table border="1" style="width:100%; border-collapse: collapse;"><thead><tr><th style="width:10%;">FROM</th><th style="width:10%;">TO</th><th style="width:80%;">PLUGGING MATERIALS</th></tr></thead><tbody><tr><td>63.5</td><td>30</td><td>Chlorinated Sand</td></tr><tr><td>30</td><td>4</td><td>Bentonite Holeplug</td></tr><tr><td>4</td><td>0</td><td>Compacted Topsoil</td></tr><tr><td> </td><td> </td><td> </td></tr><tr><td> </td><td> </td><td> </td></tr><tr><td> </td><td> </td><td> </td></tr><tr><td> </td><td> </td><td> </td></tr><tr><td> </td><td> </td><td> </td></tr></tbody></table>							FROM	TO	PLUGGING MATERIALS	63.5	30	Chlorinated Sand	30	4	Bentonite Holeplug	4	0	Compacted Topsoil															
FROM	TO	PLUGGING MATERIALS																															
63.5	30	Chlorinated Sand																															
30	4	Bentonite Holeplug																															
4	0	Compacted Topsoil																															
7 CONTRACTOR'S OR LANDOWNER'S CERTIFICATION: This water well was plugged under my jurisdiction and was completed on (mo/day/year) 6-15-00 and this record is true to the best of my knowledge and belief. Kansas Water Well Contractor's License No. 185 This Water Well Record was completed on (mo/day/year) 7-6-00 under the business name of Clarke Well & Equipment, Inc. by (signature) 																																	
INSTRUCTIONS: Use typewriter or ball point pen. Please press firmly and print clearly. Please fill in blanks, underline or circle the correct answers. Send top three copies to Kansas Department of Health & Environment, Bureau of Water, Topeka, Kansas 66620-0001. Telephone: 785/296-3565. Send one to Water Well Owner and retain one for your records.																																	