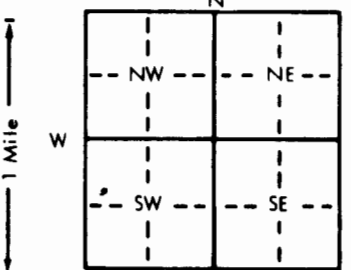


1 LOCATION OF WATER WELL:	Fraction	Section Number	Township Number	Range Number
County: BARTON	SW 1/4 NW 1/4 SW 1/4	2	T 20 S	R 14 E

Distance and direction from nearest town or city street address of well if located within city?

GREAT BEND 3W 3 1/2 S EASTSIDE

2 WATER WELL OWNER:	RR#, St. Address, Box #	City, State, ZIP Code	Board of Agriculture, Division of Water Resources
AARON'S REPAIR & SUPPLY	AIRPORT RD	GREAT BEND, KANS 67520	Application Number: 8

3 LOCATE WELL'S LOCATION WITH AN "X" IN SECTION BOX:	4 DEPTH OF COMPLETED WELL	ELEVATION:
	58 ft.	30 ft.
	Depth(s) Groundwater Encountered 1. 10 ft. 2. 30 ft. 3. 46 ft.	
	WELL'S STATIC WATER LEVEL 8 ft. below land surface measured on mo/day/yr 7-17-82	
	Pump test data: Well water was 8 ft. after 2 hours pumping 100 gpm	
	Est. Yield 8 gpm: Well water was 8 ft. after 2 hours pumping 100 gpm	
	Bore Hole Diameter 77/8 in. to 58 ft., and 58 ft. to 46 ft.	
	WELL WATER TO BE USED AS:	
	1 Domestic 3 Feedlot 6 Oil field water supply 9 Dewatering 12 Other (Specify below)	
	2 Irrigation 4 Industrial 7 Lawn and garden only 10 Observation well	
	Was a chemical/bacteriological sample submitted to Department? Yes X No X ; If yes, mo/day/yr sample was submitted	
	Water Well Disinfected? Yes X No X	

5 TYPE OF BLANK CASING USED:	5 Wrought iron	8 Concrete tile	CASING JOINTS: Glued X Clamped X
1 Steel	3 RMP (SR)	6 Asbestos-Cement	9 Other (specify below)
2 PVC	4 ABS	7 Fiberglass	10 Asbestos-cement
Blank casing diameter 5 in. to 48 ft., Dia 48 in. to 58 ft., Dia 58 in. to 46 ft.			
Casing height above land surface 12 in., weight 265 lbs./ft. Wall thickness or gauge No. 214			
TYPE OF SCREEN OR PERFORATION MATERIAL:	7 PVC	10 Asbestos-cement	
1 Steel	3 Stainless steel	5 Fiberglass	8 RMP (SR)
2 Brass	4 Galvanized steel	6 Concrete tile	9 ABS
SCREEN OR PERFORATION OPENINGS ARE: 1/16	5 Gauzed wrapped	8 Saw cut	11 None (open hole)
1 Continuous slot	3 Mill slot	6 Wire wrapped	9 Drilled holes
2 Louvered shutter	4 Key punched	7 Torch cut	10 Other (specify)
SCREEN-PERFORATED INTERVALS: From 48 ft. to 58 ft., From 58 ft. to 46 ft.			
GRAVEL PACK INTERVALS: From 38 ft. to 58 ft., From 58 ft. to 46 ft.			

6 GROUT MATERIAL:	1 Neat cement	2 Cement grout	3 Bentonite	4 Other
Grout Intervals: From 3 ft. to 38 ft., From 38 ft. to 46 ft., From 46 ft. to 58 ft.				
What is the nearest source of possible contamination:	10 Livestock pens	14 Abandoned water well		
1 Septic tank OVER 100'	4 Lateral lines	7 Pit privy	11 Fuel storage	15 Oil well/Gas well
2 Sewer lines	5 Cess pool	8 Sewage lagoon	12 Fertilizer storage	16 Other (specify below)
3 Watertight sewer lines	6 Seepage pit	9 Feedyard	13 Insecticide storage	

Direction from well?	How many feet?		
FROM TO LITHOLOGIC LOG	FROM TO LITHOLOGIC LOG		
0 4 SOIL			
4 23 GRAVEL			
23 30 CLAY			
30 36 GRAVEL			
36 46 CLAY			
46 58 GRAVEL			

7 CONTRACTOR'S OR LANDOWNER'S CERTIFICATION: This water well was (1) constructed, (2) reconstructed, or (3) plugged under my jurisdiction and was completed on (mo/day/year) 7-17-82 and this record is true to the best of my knowledge and belief. Kansas Water Well Contractor's License No. 389 This Water Well Record was completed on (mo/day/yr) 7-29-82 under the business name of REISER WATER WELL SERV INC. by (signature) Reiser
INSTRUCTIONS: Use typewriter or ball point pen, PLEASE PRESS FIRMLY and PRINT clearly. Please fill in blanks, underline or circle the correct answers. Send top three copies to Kansas Department of Health and Environment, Division of Environment, Environmental Geology Section, Topeka, KS 66620. Send one to WATER WELL OWNER and retain one for your records.