


1 LOCATION OF WATER WELL:	Fraction	Section Number	Township Number	Range Number
County: Barton	NE 1/4 NW 1/4 SE 1/4	2	T 20 S	R 14 EW

Distance and direction from nearest town or city street address of well if located within city?

Approximately 1/2 mile west and 1 1/2 miles south of Great Bend, KS

2 WATER WELL OWNER:	Raymond Brining	Board of Agriculture, Division of Water Resources
RR#, St. Address, Box #	Route 1 - Box 78	Application Number: 13420
City, State, ZIP Code	Great Bend, KS 67530	

3 LOCATE WELL'S LOCATION WITH AN "X" IN SECTION BOX:	4 DEPTH OF COMPLETED WELL: 126 ft. ELEVATION: unknown
--	---

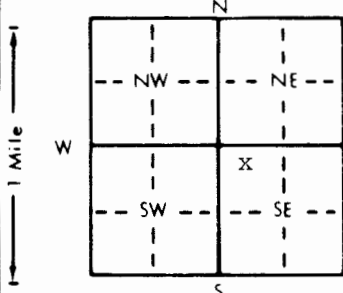

Depth(s) Groundwater Encountered	1. ft. 2. ft. 3. ft.
WELL'S STATIC WATER LEVEL	11. ft. below land surface measured on mo/day/yr
Pump test data: Well water was not ch'd. ft. after hours pumping	gpm
Est. Yield unknown gpm: Well water was ft. after hours pumping	gpm
Bore Hole Diameter	24. in. to ft. and in. to ft.
WELL WATER TO BE USED AS:	5 Public water supply 8 Air conditioning 11 Injection well
1 Domestic 3 Feedlot 6 Oil field water supply 9 Dewatering 12 Other (Specify below)	
2 Irrigation 4 Industrial 7 Lawn and garden only 10 Monitoring well	
Was a chemical/bacteriological sample submitted to Department? Yes No X If yes, mo/day/yr sample was submitted	
Water Well Disinfected? Yes No X	

5 TYPE OF BLANK CASING USED:	5 Wrought iron 8 Concrete tile CASING JOINTS: Glued Clamped
1 Steel 3 RMP (SR) 6 Asbestos-Cement 9 Other (specify below) Welded	
2 PVC 4 ABS 7 Fiberglass Threaded	
Blank casing diameter	16. in. to 44. ft. Dia 16. in. to 74. ft. Dia 16. in. to 114. ft.
Casing height above land surface	12. in. weight 42.05 lbs. ft. Wall thickness or gauge No. .250

TYPE OF SCREEN OR PERFORATION MATERIAL:	7 PVC 10 Asbestos-cement
1 Steel 3 Stainless steel 5 Fiberglass 8 RMP (SR) 11 Other (specify)	
2 Brass 4 Galvanized steel 6 Concrete tile 9 ABS 12 None used (open hole)	
SCREEN OR PERFORATION OPENINGS ARE:	5 Gauzed wrapped 8 Saw cut 11 None (open hole)
1 Continuous slot 3 Mill slot 6 Wire wrapped 9 Drilled holes	
2 Louvered shutter 4 Key punched 7 Torch cut 10 Other (specify) Bridge Slot	
SCREEN-PERFORATED INTERVALS:	From 44 ft. to 64 ft. From 74 ft. to 106 ft. From 114 ft. to 126 ft. From 126 ft. to 126 ft.
GRAVEL PACK INTERVALS:	From 20 ft. to 126 ft. From 126 ft. to 126 ft.

6 GROUT MATERIAL:	1 Neat cement 2 Cement grout 3 Bentonite 4 Other
Grout Intervals: From 0 ft. to 20 ft. From ft. to ft. From ft. to ft.	
What is the nearest source of possible contamination:	10 Livestock pens 14 Abandoned water well
1 Septic tank 4 Lateral lines 7 Pit privy 11 Fuel storage 15 Oil well/Gas well	
2 Sewer lines 5 Cess pool 8 Sewage lagoon 12 Fertilizer storage 16 Other (specify below)	
3 Watertight sewer lines 6 Seepage pit 9 Feedyard 13 Insecticide storage None known	

Direction from well?	How many feet?
FROM TO LITHOLOGIC LOG FROM TO PLUGGING INTERVALS	
0 6 Topsoil, clay, brown	
6 30 Sand and Gravel, medium, coarse	
30 44 Clay, tan	
44 64 Sand and Gravel, very fine to fine, medium	
64 74 Clay, brown	
74 80 Sand and Gravel, fine, mixed with clay	
80 85 Sand and Gravel, clean, fine to medium	
85 90 Sand and Gravel, fine, mixed with clay	
90 105 Sand and Gravel, very fine to fine with streak tan clay	
105 114 Clay, brown	
114 125 Sand and Gravel, fine to medium	
125 126 Clay, gray and broken sandstone	

7 CONTRACTOR'S OR LANDOWNER'S CERTIFICATION: This water well was (1) constructed, (2) reconstructed, or (3) plugged under my jurisdiction and was completed on (mo/day/year) 4-11-90 and this record is true to the best of my knowledge and belief. Kansas Water Well Contractor's License No. 185 This Water Well Record was completed on (mo/day/yr) 4-13-90 under the business name of Clarke Well & Equipment, Inc. by (signature) [Signature]

INSTRUCTIONS: Use typewriter or ball point pen. PLEASE PRESS FIRMLY and PRINT clearly. Please fill in blanks, underline or circle the correct answers. Send top three copies to Kansas Department of Health and Environment, Bureau of Water, Topeka, Kansas 66620-7320. Telephone: 913-296-5545. Send one to WATER WELL OWNER and retain one for your records.