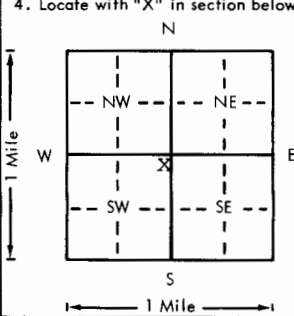


USE TYPEWRITER OR BALL
POINT PEN-PRESS FIRMLY,
PRINT CLEARLY.

WATER WELL RECORD
KSA 82a-1201-1215

Kansas Department of Health and
Environment-Division of Environment
(Water well Contractors)
Topeka, Kansas 66620

1. Location of well:		County Barton	Fraction NE 1/4 NE 1/4 SW 1/4	Section number 7	Township number T 20 S	Range number R 14 E
2. Distance and direction from nearest town or city: 8 1/2 miles Southwest of Great Bend, KS Street address of well location if in city:				3. Owner of well: Lee Turner R.R. or street: Route # 1 City, state, zip code: Great Bend, KS 67530		
4. Locate with "X" in section below:		Sketch map:			6. Bore hole dia. 24 in. Completion date 4-29-77 Well depth 64 ft.	
					7. ☐ Cable tool ☐ Rotary ☐ Driven ☐ Dug ☐ Hollow rod ☐ Jetted ☒ Bored ☒ Reverse rotary	
5. Type and color of material		From			To	
Top soil & clay		0			12	
Sand & gravel & thin clay streak at 48'		12			60	
Yellow clay		60			64	
					8. Use: ☐ Domestic ☐ Public supply ☐ Industry ☒ Irrigation ☐ Air conditioning ☐ Stock ☐ Lawn ☐ Oil field water ☐ Other	
					9. Casing: Material <u>steel</u> Height: <u>Above</u> or below Threaded ☐ Welded ☒ Surface <u>12</u> in. RMP ☐ PVC ☐ Weight <u>30.3</u> lbs./ft. Dia. <u>16</u> in. to <u>30</u> ft. depth Wall Thickness: <u>7</u> inches or Dia. <u>16</u> in. to <u>64</u> ft. depth gage No. <u>7</u> ga.	
					10. Screen: Manufacturer's name <u>Cook</u> Type <u>Double-slot</u> Dia. <u>16"</u> Slot gauge <u>1/8</u> Length <u>30'</u> Set between <u>30</u> ft. and <u>60</u> ft. ft. and <u>60</u> ft. Gravel pack? <u>yes</u> Size range of material <u>3/8-200</u>	
					11. Static water level: <u>21' 3"</u> ft. below land surface Date <u>12-28-76</u> mo./day/yr.	
					12. Pumping level below land surfaces: <u>N/C</u> ft. after <u> </u> hrs. pumping <u> </u> g.p.m. ft. after <u> </u> hrs. pumping <u> </u> g.p.m. Estimated maximum yield <u> </u> g.p.m.	
					13. Water sample submitted: <u> </u> mo./day/yr. <u> </u> Yes ☒ No Date <u> </u>	
					14. Well head completion: <u> </u> Pitless adapter <u>12</u> Inches above grade	
					15. Well grouted? <u>yes</u> With: ☒ Neat cement ☐ Bentonite ☐ Concrete Depth: From <u>0</u> ft. to <u>10</u> ft.	
					16. Nearest source of possible contamination: <u>Field</u> ft. <u> </u> Direction <u> </u> Type <u> </u> Well disinfected upon completion? <u> </u> Yes ☒ No	
					17. Pump: <u> </u> Not installed Manufacturer's name <u>Peerless Pump</u> Model number <u>14LC-1</u> HP <u>40</u> Volts <u>460</u> Length of drop pipe <u>50</u> ft. capacity <u>1600</u> g.p.m. Type: ☐ Submersible ☒ Turbine ☐ Jet ☐ Reciprocating ☐ Centrifugal ☐ Other	
		(Use a second sheet if needed)				
18. Elevation:		19. Remarks:			20. Water well contractor's certification: This well was drilled under my jurisdiction and this report is true to the best of my knowledge and belief. Clarke Well & Eq., Inc. 185 Business name <u>Great Bend, KS 67530</u> License No. <u> </u> Address <u> </u> Date <u>5-4-77</u> Signed <u> </u> Authorized representative	
Topography: ☐ Hill ☐ Slope ☐ Upland ☐ Valley						

Forward the white, blue and pink copies to the Department of Health and Environment

Form WWC-5