USE TYPEWRITER OR BALL POINT PEN-PRESS FIRMLY, PRINT CLEARLY.

T R EW sec 1/4 1/4 1/4 No.

WATER WELL RECORD
KSA 82a-1201-1215

Kansas State Dept. Of Health
(Water Well Contractors)
Forbes-Bldg. 740
Topeka, Kansas 66620

1 Location of well:	County	Township name	Fraction	Section number	Town number	Range number
	Barton		SENE	16	20S	14W

Distance and direction from nearest town or city: 1¼ E
Street address of well location if in city: Dundee, Ks

3 Owner of well: Ronald Rowe
Address: R1 Great Bend, KS

Locate with "X" in section below: Sketch map:

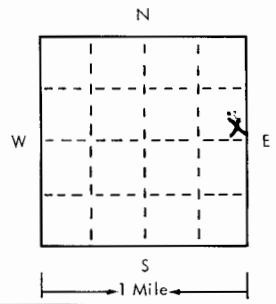

4 Well depth: 50 ft. Date of completion 6-2-75
Well diameter 7 in. 7"

5 ☐ Cable tool ☒ Rotary ☐ Driven ☐ Dug
☐ Hollow rod ☐ Jetted ☐ Bored ☐ Reverse rotary

6 Use: ☒ Domestic ☐ Public supply ☐ Industry
☐ Irrigation ☐ Air conditioning ☐ Commercial
☐ Test well ☐ _____

7 Casing: Material PVC Height: (above)/below
Threaded ☐ Welded ☐ Surface 12 in.
Diam. Weight ____ lbs./ft.
4 in. to 50 ft. depth Drive shoe? ☐ Yes ☒ No
____ in. to ____ ft. depth

2 Type and color of material	From	To
Top Soil - Clay	0	6
Sand - Gravel	6	27
Clay	27	30
Sand - Gravel	30	50
(use a second sheet if needed)		

8 Screen:
Manufacturer MPI
Type PVC Dia. 4"
Slot/gauze 40 Length 20"
Set between 30 ft. and 50 ft.
Fittings: 1/8 - 3/4"
Gravel pack ☒ Yes ☐ No Size range of material ____

9 Static water level:
8 ft. below land surface Date 6-2-75

10 Pumping level below land surfaces:
____ ft. after ____ hrs. pumping ____ g.p.m.
____ ft. after ____ hrs. pumping ____ g.p.m.
Estimated maximum yield 50 g.p.m.

11 Water sample submitted:
☐ Yes ☒ No Date ____

12 Well head completion:
☐ Pitless adapter ☒ 12 Inches above grade

13 Well grouted? ☒ Yes ☐ No
☒ Neat cement ☐ Bentonite ☐ _____
Depth: From 0 ft. to 10 ft.

14 Nearest source of possible contamination:
ft. 60 Direction SE Type Septic Tank
Well disinfected upon completion? ☒ Yes ☐ No

15 Pump: ☐ Not installed
Manufacturer's name Goulds
Model number 4B HP 3/4 Volts 230
Length of drop pipe 20 ft. capacity 15 g.m.p.
Type:
☐ Submersible ☐ Turbine
☐ Jet ☐ Reciprocating
☒ Certrifugal ☐ Other

16 Remarks: elevation

Topography:
☐ Hill
☐ Slope
☐ Upland
☒ Valley

17 Water well contractor's certification:
This well was drilled under my jurisdiction and this report is true to the best of my knowledge and belief.
Business name Kelly's Waterwell Serv License No. 186
Address R 3 Great Bend KS
Signed Kelly Price Date 6-10-75
Authorized representative

Forward the white, blue and pink copies to the Kansas State Dept. Of Health.

Form WWC-5

677-H