In Dundee

USE TYPEWRITER OR BALL POINT PEN-PRESS FIRMLY, PRINT CLEARLY.

WATER WELL RECORD
KSA 82a-1201-1215

Kansas Department of Health and Environment-Division of Environment
(Water well Contractors)
Topeka, Kansas 66620

1. Location of well:	County	Fraction	Section number	Township number	Range number
	Barton	1/4 NW 1/4 SE 1/4	17	T 20 S	R 14 E (W)

2. Distance and direction from nearest town or city: 8½ miles SW of Great Bend, KS 67530.
Street address of well location if in city:

3. Owner of well: Edna E. Unruh
R.R. or street: Route 4
City, state, zip code: Great Bend, KS 67530

4. Locate with "X" in section below: Sketch map:

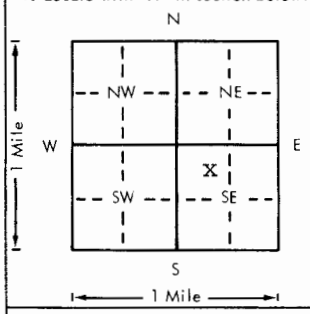

6. Bore hole dia. 5 in. Completion date 11-9-77
Well depth 75 ft.

7. ___ Cable tool ___ Rotary ___ Driven ___ Dug
___ Hollow rod ___ Jetted ___ Bored X Reverse rotary

8. Use: X Domestic ___ Public supply ___ Industry
___ Irrigation ___ Air conditioning ___ Stock
___ Lawn ___ Oil field water ___ Other

9. Casing: Material PVC Height (Above) or below
Threaded ___ Welded X Surface 12 in.
RMP ___ PVC ___ Weight .5 lbs./ft.
Dia. 2 in. to 68 ft. depth Wall Thickness: inches or
Dia. ___ in. to ___ ft. depth gage No. .091

5. Type and color of material	From	To
Top soil	0	2
Brown Clay	2	8
Sand & gravel	8	44
Yellow & Blue clay	44	55
Sand and clay streaks	55	66
Sand and gravel	66	74
Dakota Clay	74	75
(Use a second sheet if needed)		

10. Screen: Manufacturer's name Peerless Plastics
Type PVC Dia. 2"
Slot/gauze 1/8 Length 7'
Set between 68 ft. and 75 ft.
___ ft. and ___ ft.
Gravel pack? yes Size range of material 3/8-200

11. Static water level: mo./day/yr.
13 ft. below land surface Date 11 / 9/77

12. Pumping level below land surfaces: NC
___ ft. after ___ hrs. pumping ___ g.p.m.
___ ft. after ___ hrs. pumping ___ g.p.m.
Estimated maximum yield ___ g.p.m.

13. Water sample submitted: mo./day/yr.
___ Yes X No Date

14. Well head completion:
___ Pitless adapter 12 Inches above grade

15. Well grouted? yes
With: X Neat cement ___ Bentonite ___ Concrete
Depth: From 0 ft. to 10 ft.

16. Nearest source of possible contamination:
ft. ___ Direction ___ Type FIELD
Well disinfected upon completion? X Yes ___ No

17. Pump: X Not installed
Manufacturer's name
Model number HP Volts
Length of drop pipe ft. capacity g.p.m.
Type:
___ Submersible ___ Turbine
___ Jet ___ Reciprocating
___ Centrifugal ___ Other

18. Elevation:
Topography:
___ Hill
___ Slope
___ Upland
___ Valley

19. Remarks:

20. Water well contractor's certification:
This well was drilled under my jurisdiction and this report is true to the best of my knowledge and belief.
Clarke Well & Equip. Inc. 185
Business name License No.
Address Great Bend, KS 67530
Signed [signature] Date 11/14/77
Authorized representative

T 20 R 14 E (W) Sec 17 1/4 NW 1/4 SE 1/4

Forward the white, blue and pink copies to the Department of Health and Environment

Form WWC-5

M1-1023