USE TYPEWRITER OR BALL POINT PEN-PRESS FIRMLY, PRINT CLEARLY.

WATER WELL RECORD
KSA 82a-1201-1215

Kansas Department of Health and Environment-Division of Environment
(Water well Contractors)
Topeka, Kansas 66620

1. Location of well:	County	Fraction	Section number	Township number	Range number
	Barton	E½ 1/4 1/4 NE 1/4	18	T 20 S	R 14 E (W)

2. Distance and direction from nearest town or city:
9 miles Southwest of Great BEnd, KS
Street address of well location if in city:

3. Owner of well: Dr. Reiff Brown
R.R. or street: Route 1
City, state, zip code: Great Bend, KS 67530

4. Locate with "X" in section below: Sketch map:

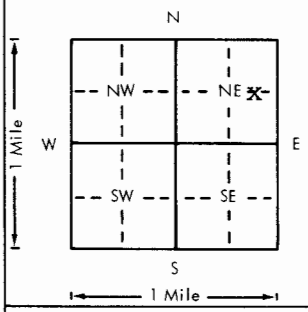

6. Bore hole dia. 24 in. Completion date 3-14-77
Well depth 62 ft.

7. __ Cable tool __ Rotary __ Driven __ Dug
__ Hollow rod __ Jetted __ Bored X Reverse rotary

8. Use: __ Domestic __ Public supply __ Industry
X Irrigation __ Air conditioning __ Stock
__ Lawn __ Oil field water __ Other

9. Casing: Material steel Height: (Above) or below
Threaded ___ Welded X Surface 12 in.
RMP ___ PVC ___ Weight 30.3 lbs./ft.
Dia. 16 in. to 24 ft. depth Wall Thickness: inches or
Dia. 16 in. to 62 ft. depth gage No. 7 ga.

5. Type and color of material	From	To
Top soil & clay	0	7
Sand & gravel	7	55
Brown clay	55	73
(Use a second sheet if needed)		

10. Screen: Manufacturer's name D-Doerr
C-Cook
Type Double-slot Dia. 16"
(Slot)/gauze 1/8 Length D-12' & C-20'
Set between D--24 ft. and 36 ft.
C--36 ft. and 56 ft.
Gravel pack? yes Size range of material 3/8-200

11. Static water level: mo./day/yr.
13 ft. below land surface Date 2-18-77

12. Pumping level below land surfaces: N/C
___ ft. after ___ hrs. pumping ___ g.p.m.
___ ft. after ___ hrs. pumping ___ g.p.m.
Estimated maximum yield ___ g.p.m.

13. Water sample submitted: mo./day/yr.
___ Yes X No Date ___

14. Well head completion:
___ Pitless adapter 12 Inches above grade

15. Well grouted? yes
With: xx Neat cement ___ Bentonite ___ Concrete
Depth: From 0 ft. to 10 ft.

16. Nearest source of possible contamination:
ft. ___ Direction ___ Type FIELD
Well disinfected upon completion? ___ Yes X No

17. Pump: ___ Not installed
Manufacturer's name Peerless Pumps
Model number 12MB-2 HP 60 Volts --
Length of drop pipe 50 ft. capacity 900 g.p.m.
Type:
___ Submersible X Turbine
___ Jet ___ Reciprocating
___ Centrifugal ___ Other

T 20 R 14 E (W) Sec 18 1/4 1/4 1/4 1/4 EW NE

18. Elevation:
Topography:
___ Hill
___ Slope
___ Upland
___ Valley

19. Remarks:

20. Water well contractor's certification:
This well was drilled under my jurisdiction and this report is true to the best of my knowledge and belief.
Business name Clarke Well & Equip., Inc. License No. 185
Address Great Bend, KS 67530
Signed [signature] Date 3-23-77
Authorized representative

Forward the white, blue and pink copies to the Department of Health and Environment

Form WWC-5

MI-1023