

1] LOCATION OF WATER WELL:		Fraction	Section Number	Township Number	Range Number
County: Barton		C 1/4 SE 1/4 1/4	18	T 20 S	R 14W E/W

Distance and direction from nearest town or city street address of well if located within city?


3/4 W of Dundee, Kansas

2	WATER WELL OWNER:	Darrell Clarke	Woodman & Iannitti	Clarke, No. 2
	RR#, St. Address, Box # :	709 Patton Road	1008 Douglas Bld.	Board of Agriculture, Division of Water Resources
	City, State, ZIP Code :	Great Bend, Ks. 67530	Wichita, Ks. 67202	Application Number: Unknown

3 LOCATE WELL'S LOCATION WITH AN "X" IN SECTION BOX: 4 DEPTH OF COMPLETED WELL: 48 ft. ELEVATION: Unknown

Depth(s) Groundwater Encountered 1. 10 ft. 2. ft. 3. ft.

WELL'S STATIC WATER LEVEL 18 ft. below land surface measured on mo/day/yr 12/9/83

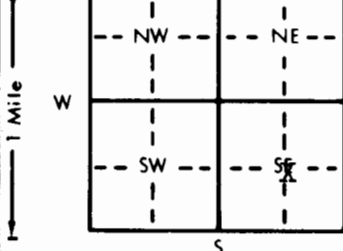

Pump test data: Well water was ft. after hours pumping gpm
 Est. Yield 60 gpm: Well water was ft. after hours pumping gpm
 Bore Hole Diameter 8 in. to 48 ft., and in. to ft.

WELL WATER TO BE USED AS:

1 Domestic	3 Feedlot	<u>6 Oil field water supply</u>	9 Dewatering	12 Other (Specify below)
2 Irrigation	4 Industrial	7 Lawn and garden only	10 Observation well	

Was a chemical/bacteriological sample submitted to Department? Yes.....No.....; If yes, mo/day/yr sample was submitted.....
 Water Well Disinfected? Yes..... No.....

5 TYPE OF BLANK CASING USED:		5 Wrought iron	8 Concrete tile	CASING JOINTS: <u>Glued</u> Clamped
1 Steel	3 RMP (SR)	6 Asbestos-Cement	9 Other (specify below)	Welded
2 PVC	4 ABS	7 Fiberglass		Threaded

Blank casing diameter 5 . . . in. to 28 . . . ft., Dia in. to . . . ft., Dia in. to . . . ft.
Casing height above land surface . . . 12 . . . in., weight . . . 2.8 . . . lbs./ft. Wall thickness or gauge No. . . Sch. 40

TYPE OF SCREEN OR PERFORATION MATERIAL:

1 Steel	3 Stainless steel	5 Fiberglass	7 <u>PVC</u>	10 Asbestos-cement
2 Brass	4 Galvanized steel	6 Concrete tile	8 <u>RMP</u> (SR)	11 Other (specify)
			9 ABS	12 None used (open hole)

SCREEN OR PERFORATION OPENINGS ARE:

1 Continuous slot	3 Mill slot	5 Gauzed wrapped	8 <u>Saw cut</u>	11 None (open hole)
2 Louvered shutter	4 Key punched	6 Wire wrapped	9 Drilled holes	
		7 Torch cut	10 Other (specify)	

SCREEN-PERFORATED INTERVALS:		From 28	ft. to 48	ft., From	ft. to	ft.
		From	ft. to	ft., From	ft. to	ft.
GRAVEL PACK INTERVALS:		From 10	ft. to 48	ft., From	ft. to	ft.
		From	ft. to	ft. From	ft. to	ft.

6	GROUT MATERIAL: <table border="0"> <tr> <td>1 Neat cement</td> <td>2 Cement grout</td> <td>3 Bentonite</td> <td>4 Other</td> </tr> </table>	1 Neat cement	2 Cement grout	3 Bentonite	4 Other
1 Neat cement	2 Cement grout	3 Bentonite	4 Other		

Grout Intervals: From 0 ft. to 10 ft., From ft. to ft., From ft. to ft.

What is the nearest source of possible contamination:

1 Septic tank	4 Lateral lines	7 Pit privy	10 Livestock pens	14 Abandoned water well
2 Sewer lines	5 Cess pool	8 Sewage lagoon	11 Fuel storage	15 <u>Oil well/Gas well</u>
3 Watertight sewer lines	6 Seepage pit	9 Feedyard	12 Fertilizer storage	16 Other (specify below)
			13 Insecticide storage	

Direction from well? South How many feet? 60

[illegible]

7 CONTRACTOR'S OR LANDOWNER'S CERTIFICATION: This water well was (1) constructed, (2) reconstructed, or (3) plugged under my jurisdiction and was completed on (mo/day/year) . . . 12/9/83 and this record is true to the best of my knowledge and belief, Kansas Water Well Contractor's License No. . . . 186 This Water Well Record was completed on (mo/day/yr) 1/10/84 under the business name of Kellys Water Well Service by (signature) [Signature]

INSTRUCTIONS: Use typewriter or ball point pen, PLEASE PRESS FIRMLY and PRINT clearly. Please fill in blanks, underline or circle the correct answers. Send top three copies to Kansas Department of Health and Environment, Division of Environment, Environmental Geology Section, Topeka, KS 66620. Send one to WATER WELL OWNER and retain one for your records.