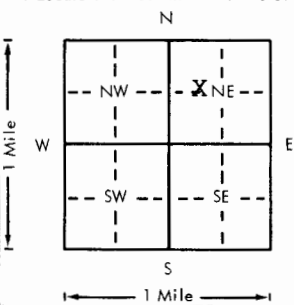


4

USE TYPEWRITER OR BALL
POINT PEN-PRESS FIRMLY,
PRINT CLEARLY.

WATER WELL RECORD
KSA 82a-1201-1215

Kansas Department of Health and
Environment-Division of Environment
(Water well Contractors)
Topeka, Kansas 66620

1. Location of well:		County Barton	Fraction Center of 1/4 West 1/2 NE 1/4	Section number 20	Township number T 20 S R 14 E	Range number 14
2. Distance and direction from nearest town or city: 9 miles Southwest of Great Bend, KS Street address of well location if in city:			3. Owner of well: Darrell W. Clarke R.R. or street: 709 Patton Rd. City, state, zip code: Great Bend, KS 67530			
4. Locate with "X" in section below: 			Sketch map:		6. Bore hole dia. 24 in. Completion date 12-19-77 Well depth 93 ft.	
5. Type and color of material			From	To	7. ☐ Cable tool ☐ Rotary ☐ Driven ☐ Dug ☐ Hollow rod ☐ Jetted ☒ Bored ☒ Reverse rotary	
					8. Use: ☐ Domestic ☐ Public supply ☐ Industry ☒ Irrigation ☐ Air conditioning ☐ Stock ☐ Lawn ☐ Oil field water ☐ Other	
					9. Casing: Material <u>steel</u> Height: <u>Above</u> or below Threaded ☐ Welded ☒ Surface <u>12</u> in. RMP ☐ PVC ☐ Weight <u>30.3</u> lbs./ft. Dia. <u>16</u> in. to <u>20</u> ft. depth Wall Thickness: inches or Dia. <u>16</u> in. to <u>81</u> ft. depth gage No. <u>7 ga.</u>	
					10. Screen: Manufacturer's name <u>W. A. Brown</u> Type <u>Double-slot</u> Dia. <u>16"</u> ☒ Slot gauze <u>1/8"</u> Length <u>58'</u> Set between <u>20</u> ft. and <u>66</u> ft. <u>81</u> ft. and <u>93</u> ft. Gravel pack? <u>Yes</u> Size range of material <u>3/8-200</u>	
					11. Static water level: <u>N/C</u> mo./day/yr. <u>N/C</u> ft. below land surface Date <u> </u>	
					12. Pumping level below land surfaces: <u>N/C</u> <u> </u> ft. after <u> </u> hrs. pumping <u> </u> g.p.m. <u> </u> ft. after <u> </u> hrs. pumping <u> </u> g.p.m. Estimated maximum yield <u> </u> g.p.m.	
					13. Water sample submitted: <u> </u> mo./day/yr. ☐ Yes ☒ No Date <u> </u>	
					14. Well head completion: ☐ Pitless adapter <u>12</u> Inches above grade	
					15. Well grouted? <u>Yes</u> With: ☒ Neat cement ☐ Bentonite ☐ Concrete Depth: From <u>0</u> ft. to <u>10</u> ft.	
					16. Nearest source of possible contamination: <u>FIELD</u> ft. <u> </u> Direction <u> </u> Type <u> </u> Well disinfected upon completion? ☐ Yes ☒ No	
		17. Pump: Manufacturer's name <u>Berkeley Pump Co.</u> Not installed Model number <u>B4JRM</u> HP <u>50</u> Volts <u>Engine</u> Length of drop pipe <u>30</u> ft. capacity <u>800</u> g.p.m. Type: ☐ Submersible ☐ Turbine ☐ Jet ☐ Reciprocating ☒ Centrifugal ☐ Other				
(Use a second sheet if needed)						
18. Elevation: 1876 Topography: ☐ Hill ☐ Slope ☐ Upland ☐ Valley		19. Remarks:		20. Water well contractor's certification: This well was drilled under my jurisdiction and this report is true to the best of my knowledge and belief. Clarke Well & Eq., Inc. 185 Business name License No. Address Great Bend, KS 67530 Signed <u>Darrell W. Clarke</u> Date 12-19-78 Authorized representative		

Forward the white, blue and pink copies to the Department of Health and Environment

Form WWC-5