

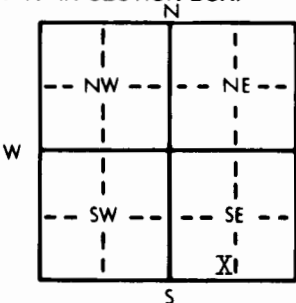
LOCATION OF WATER WELL: County: Barton	Fraction SE $\frac{1}{4}$ SW $\frac{1}{4}$ SE $\frac{1}{4}$	Section Number 25	Township Number T 20 S	Range Number R 14 W E/W
--	---	-----------------------------	---	---

Distance and direction from nearest town or city street address of well if located within city?

8 E, 1 1/4 N of Pawnee Rock, Kansas

WATER WELL OWNER: Harold Titus	Mohawk Drilling	Titus D1
Address, Box #: Route 2	614 Patton Road	Board of Agriculture, Division of Water Resources
City, State, ZIP Code: Great Bend, Ks. 67530	Great Bend, Ks. 67530	Application Number: Unknown

LOCATE WELL'S LOCATION WITH AN "X" IN SECTION BOX:

DEPTH OF COMPLETED WELL: **65** ft. ELEVATION: **Unknown**Depth(s) Groundwater Encountered **1. 20** ft. 2. **20** ft. 3. **9/27/83** ft.WELL'S STATIC WATER LEVEL **20** ft. below land surface measured on mo/day/yrPump test data: Well water was **60** gpm: Well water was **65** ft. after **8** hours pumping **65** gpmEst. Yield **60** gpm: Well water was **65** ft. after **8** hours pumping **65** gpmBore Hole Diameter **8** in. to **65** ft., and **65** in. to **65** ft.

WELL WATER TO BE USED AS: 5 Public water supply 8 Air conditioning 11 Injection well

1 Domestic 3 Feedlot 6 Oil field water supply 9 Dewatering 12 Other (Specify below)

2 Irrigation 4 Industrial 7 Lawn and garden only 10 Observation well

Was a chemical/bacteriological sample submitted to Department? Yes **No**; If yes, mo/day/yr sample was submittedWater Well Disinfected? Yes **No**

TYPE OF BLANK CASING USED:

1 Steel 3 RMP (SR) 5 Wrought iron 8 Concrete tile CASING JOINTS: Glued Clamped2 PVC 4 ABS 6 Asbestos-Cement 9 Other (specify below) WeldedBlank casing diameter **5** in. to **45** ft., Dia **5** in. to **45** ft., Dia **5** in. to **45** ft.Casing height above land surface **12** in., weight **2.8** lbs./ft. Wall thickness or gauge No. **Sch. 40**

TYPE OF SCREEN OR PERFORATION MATERIAL:

1 Steel 3 Stainless steel 5 Fiberglass 7 PVC 10 Asbestos-cement

2 Brass 4 Galvanized steel 6 Concrete tile 8 RMP (SR) 11 Other (specify)

SCREEN OR PERFORATION OPENINGS ARE: 5 Gauzed wrapped 8 Saw cut 11 None (open hole)

1 Continuous slot 3 Mill slot 6 Wire wrapped 9 Drilled holes

2 Louvered shutter 4 Key punched 7 Torch cut 10 Other (specify)



GROUT MATERIAL: 1 Neat cement 2 Cement grout 3 Bentonite 4 Other

Grout Intervals: From **0** ft. to **10** ft., From **0** ft. to **10** ft., From **0** ft. to **10** ft.

What is the nearest source of possible contamination:

1 Septic tank 4 Lateral lines 7 Pit privy 10 Livestock pens 14 Abandoned water well

2 Sewer lines 5 Cess pool 8 Sewage lagoon 11 Fuel storage 15 Oil well/Gas well

3 Watertight sewer lines 6 Seepage pit 9 Feedyard 12 Fertilizer storage 16 Other (specify below)

Direction from well? **South** How many feet? **60**

FROM TO LITHOLOGIC LOG FROM TO LITHOLOGIC LOG

0 20 Clay20 65 Sand and GravelCONTRACTOR'S OR LANDOWNER'S CERTIFICATION: This water well was (1) constructed, (2) reconstructed, or (3) plugged under my jurisdiction and was completed on (mo/day/year) **9/27/83** and this record is true to the best of my knowledge and belief. KansasWater Well Contractor's License No. **186** This Water Well Record was completed on (mo/day/yr) **11/7/83**Under the business name of **Kellys Water Well Service** by (signature) **Kellys Water Well Service**INSTRUCTIONS: Use typewriter or ball point pen, PLEASE PRESS FIRMLY and PRINT clearly. Please fill in blanks, underline or circle the correct answers. Send top three copies to Kansas Department of Health and Environment, Division of Environment, Environmental Geology Section, Topeka, KS 66620. Send one to WATER WELL OWNER and retain one for your records.

OFFICE USE ONLY

T

R

14

E/W

SEC.

25

SE 1/4

SW 1/4

SE 1/4