

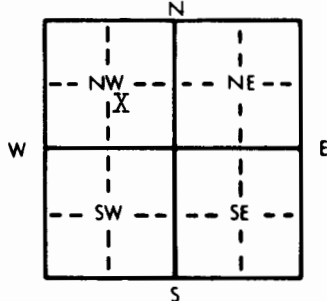
LOCATION OF WATER WELL: County: <u>Barton</u>	Fraction <u>NW</u> $\frac{1}{4}$ <u>SE</u> $\frac{1}{4}$ <u>NW</u> $\frac{1}{4}$	Section Number <u>27</u>	Township Number <u>T 20</u> <u>S</u>	Range Number <u>R 14W</u> <u>E/W</u>
--	---	-----------------------------	---	---

Distance and direction from nearest town or city street address of well if located within city?

1 N, 6 $\frac{1}{2}$ E of Pawnee Rock, Kansas

WATER WELL OWNER: <u>Pete Kirkman</u>	<u>Duke Drilling</u>	<u>Dundee No. 1</u>
R#, St. Address, Box #: <u>Great Bend, Ks.</u>	<u>Box 823</u>	Board of Agriculture, Division of Water Resources
City, State, ZIP Code: <u>67530</u>	<u>Great Bend, Ks. 67530</u>	Application Number: <u>Unknown</u>

LOCATE WELL'S LOCATION WITH AN "X" IN SECTION BOX:

DEPTH OF COMPLETED WELL: 62 ft. ELEVATION: UnknownDepth(s) Groundwater Encountered 1. 14 ft. 2. _____ ft. 3. _____ ft.WELL'S STATIC WATER LEVEL: 14 ft. below land surface measured on mo/day/yr 3/27/84

Pump test data: Well water was _____ ft. after _____ hours pumping _____ gpm

Est. Yield 60 gpm: Well water was _____ ft. after _____ hours pumping _____ gpmBore Hole Diameter 8 in. to 62 ft., and _____ in. to _____ ft.

WELL WATER TO BE USED AS: 5 Public water supply 8 Air conditioning 11 Injection well

1 Domestic 3 Feedlot 6 Oil field water supply 9 Dewatering 12 Other (Specify below)

2 Irrigation 4 Industrial 7 Lawn and garden only 10 Observation well

Was a chemical/bacteriological sample submitted to Department? Yes _____ No _____; If yes, mo/day/yr sample was submitted _____

Water Well Disinfected? Yes _____ No _____

TYPE OF BLANK CASING USED:

1 Steel 3 RMP (SR) 5 Wrought iron 8 Concrete tile CASING JOINTS: Glued _____ Clamped _____2 PVC 4 ABS 6 Asbestos-Cement 9 Other (specify below) _____ Welded _____Blank casing diameter _____ in. to 42 ft., Dia _____ in. to _____ ft., Dia _____ in. to _____ ft.Casing height above land surface: 12 in., weight 2.8 lbs./ft. Wall thickness or gauge No. Sch. 40

TYPE OF SCREEN OR PERFORATION MATERIAL:

1 Steel 3 Stainless steel 5 Fiberglass 7 PVC 10 Asbestos-cement

2 Brass 4 Galvanized steel 6 Concrete tile 8 RMP (SR) 11 Other (specify) _____

GREEN OR PERFORATION OPENINGS ARE: 5 Gauzed wrapped 8 Saw cut 11 None (open hole)

1 Continuous slot 3 Mill slot 6 Wire wrapped 9 Drilled holes

2 Louvered shutter 4 Key punched 7 Torch cut 10 Other (specify) _____

GREEN-PERFORATED INTERVALS: From _____ ft. to 62 ft., From _____ ft. to _____ ft.

From _____ ft. to _____ ft., From _____ ft. to _____ ft.

GRAVEL PACK INTERVALS: From _____ ft. to 62 ft., From _____ ft. to _____ ft.

From _____ ft. to _____ ft., From _____ ft. to _____ ft.

GROUT MATERIAL: 1 Neat cement 2 Cement grout 3 Bentonite 4 Other _____Grout intervals: From _____ ft. to 10 ft., From _____ ft. to _____ ft., From _____ ft. to _____ ft.

What is the nearest source of possible contamination:

1 Septic tank 4 Lateral lines 7 Pit privy 10 Livestock pens 14 Abandoned water well

2 Sewer lines 5 Cess pool 8 Sewage lagoon 11 Fuel storage 15 Oil well/Gas well

3 Watertight sewer lines 6 Seepage pit 9 Feedyard 12 Fertilizer storage 16 Other (specify below)

Direction from well? South How many feet? 60

FROM TO LITHOLOGIC LOG FROM TO LITHOLOGIC LOG

0 10 Clay10 62 Sand and GravelCONTRACTOR'S OR LANDOWNER'S CERTIFICATION: This water well was (1) constructed, (2) reconstructed, or (3) plugged under my jurisdiction and was completed on (mo/day/year) 3/27/84 and this record is true to the best of my knowledge and belief. KansasWater Well Contractor's License No. 186 This Water Well Record was completed on (mo/day/yr) 4/30/84Under the business name of Kellys Water Well Service by (signature) [Signature]

INSTRUCTIONS: Use typewriter or ball point pen, PLEASE PRESS FIRMLY and PRINT clearly. Please fill in blanks, underline or circle the correct answers. Send top three copies to Kansas Department of Health and Environment, Division of Environment, Environmental Geology Section, Topeka, KS 66620. Send one to WATER WELL OWNER and retain one for your records.