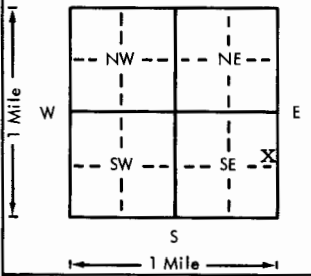


USE TYPEWRITER OR BALL
POINT PEN-PRESS FIRMLY,
PRINT CLEARLY.

WATER WELL RECORD
KSA 82a-1201-1215

Kansas Department of Health and
Environment-Division of Environment
(Water well Contractors)
Topeka, Kansas 66620

1. Location of well:		County Barton	Fraction SE 1/4 NE 1/4 SE 1/4	Section number 27	Township number T 20 S R 14	Range number 14
2. Distance and direction from nearest town or city: 8 miles Southwest of Great Bend, KS Street address of well location if in city:			3. Owner of well: K. W. Kirkman R.R. or street: 1909 Lincoln City, state, zip code: Great Bend, KS 67530			
4. Locate with "X" in section below:		Sketch map:		6. Bore hole dia. 5 in. Completion date 6-24-77 Well depth 52 ft.		
				7. ☐ Cable tool ☐ Rotary ☐ Driven ☐ Dug ☐ Hollow rod ☐ Jetted ☐ Bored ☒ Reverse rotary		
5. Type and color of material		From	To	8. Use: ☐ Domestic ☐ Public supply ☐ Industry ☐ Irrigation ☐ Air conditioning ☒ Stock ☐ Lawn ☐ Oil field water ☐ Other		
Top soil & sandy clay		0	9	9. Casing: Material Galv. Height: Above or below Threaded ☐ Welded ☒ Surface 12 in. RMP ☐ PVC ☐ Weight ☐ lbs./ft. Dia. 2 in. to 42 ft. depth Wall Thickness: inches or Dia. 1 in. to 42 ft. depth Gage No. Std. steel		
Fine sand		9	15	10. Screen: Manufacturer's name Peerless Plastics Type PVC 160 Dia. 2" ☒ Slot/gauze 1/8 Length XX 10' Set between 42 ft. and 52 ft. ft. and 52 ft. Gravel pack? yes Size range of material 3/8-200		
Clay		15	20	11. Static water level: 12' 4" ft. below land surface Date 6-24-77 mo./day/yr.		
Sand & gravel		20	52	12. Pumping level below land surfaces: N/C ft. after 0 hrs. pumping 0 g.p.m. ft. after 0 hrs. pumping 0 g.p.m. Estimated maximum yield 0 g.p.m.		
				13. Water sample submitted: 0 mo./day/yr. Yes ☒ No ☐ Date 6-24-77		
				14. Well head completion: ☐ Pitless adapter 12 Inches above grade		
				15. Well grouted? yes With: ☒ Neat cement ☐ Bentonite ☐ Concrete Depth: From 0 ft. to 10 ft.		
				16. Nearest source of possible contamination: FIELD ft. 0 Direction SE Type FIELD Well disinfected upon completion? ☒ Yes ☐ No		
				17. Pump: ☐ Not installed Manufacturer's name Clayton Mark & Co. Model number 450 HP 1/2 Volts 115 Length of drop pipe 42' ft. capacity 1 g.p.m. Type: 2" x 10" brass cylinder ☐ Submersible ☐ Turbine ☐ Jet ☒ Reciprocating ☐ Centrifugal ☐ Other		
18. Elevation:		19. Remarks:		20. Water well contractor's certification: This well was drilled under my jurisdiction and this report is true to the best of my knowledge and belief. Clarke Well & Eq., Inc. 185 Business name Great Bend, KS 67530 license No. 185 Address Great Bend, KS 67530 Signed [Signature] Date 7-5-77 Authorized representative		

Forward the white, blue and pink copies to the Department of Health and Environment

Form WWC-5