WATER WELL RECORD Form WWC-5 KSA 82a-1212

LOCATION OF WATER WELL:	Fraction	Section Number	Township Number	Range Number
ounty: Barton	Near Center of ¼ ¼ SW ¼	28	T 20 S	R 14 (W)

istance and direction from nearest town or city street address of well if located within city?
Approx. 2½ miles west and 6 miles south of Great Bend, KS 67530

WATER WELL OWNER: Christina Ohnmacht
R#, St. Address, Box # : 3728 Robin Road
ity, State, ZIP Code : Great Bend, KS 67530

Board of Agriculture, Division of Water Resources
Application Number: not available

LOCATE WELL'S LOCATION WITH AN "X" IN SECTION BOX:

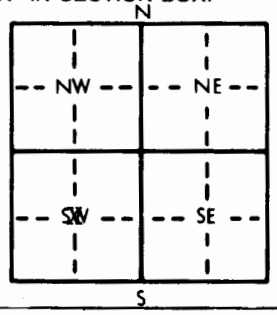

4 DEPTH OF COMPLETED WELL 129 ft. ELEVATION: Unknown
Depth(s) Groundwater Encountered 1. 9 ft. 2. ft. 3. ft.
WELL'S STATIC WATER LEVEL 9 ft. below land surface measured on mo/day/yr 3-1-82
Pump test data: Well water was not ck'd ft. after hours pumping gpm
Est. Yield 1000 gpm: Well water was ft. after hours pumping gpm
Bore Hole Diameter 24 in. to 129 ft., and in. to ft.
WELL WATER TO BE USED AS: 1 Domestic 2 Irrigation 3 Feedlot 4 Industrial 5 Public water supply 6 Oil field water supply 7 Lawn and garden only 8 Air conditioning 9 Dewatering 10 Observation well 11 Injection well 12 Other (Specify below)
Was a chemical/bacteriological sample submitted to Department? Yes No XX; If yes, mo/day/yr sample was submitted
Water Well Disinfected? Yes No XX

TYPE OF BLANK CASING USED: 1 Steel 2 PVC 3 RMP (SR) 4 ABS 5 Wrought iron 6 Asbestos-Cement 7 Fiberglass 8 Concrete tile 9 Other (specify below)
CASING JOINTS: Glued Clamped Welded XX Threaded
lank casing diameter 16 in. to 61 ft., Dia 16 in. to 89 ft., Dia in. to ft.
asing height above land surface 12 in., weight 42.05 lbs./ft. Wall thickness or gauge No. .250

YPE OF SCREEN OR PERFORATION MATERIAL: 1 Steel 2 Brass 3 Stainless steel 4 Galvanized steel 5 Fiberglass 6 Concrete tile 7 PVC 8 RMP (SR) 9 ABS 10 Asbestos-cement 11 Other (specify) 12 None used (open hole)
CREEN OR PERFORATION OPENINGS ARE: 1 Continuous slot 2 Louvered shutter 3 Mill slot 4 Key punched 5 Gauzed wrapped 6 Wire wrapped 7 Torch cut 8 Saw cut 9 Drilled holes 10 Other (specify) Doerr Bridge Slot 11 None (open hole)
CREEN-PERFORATED INTERVALS: From 61 ft. to 73 ft., From ft. to ft.
From 89 ft. to 129 ft., From ft. to ft.
GRAVEL PACK INTERVALS: From 10 ft. to 129 ft., From ft. to ft.
From ft. to ft., From ft. to ft.

GROUT MATERIAL: 1 Neat cement 2 Cement grout 3 Bentonite 4 Other
rout Intervals: From 0 ft. to 10 ft., From ft. to ft., From ft. to ft.
/hat is the nearest source of possible contamination: 1 Septic tank 2 Sewer lines 3 Watertight sewer lines 4 Lateral lines 5 Cess pool 6 Seepage pit 7 Pit privy 8 Sewage lagoon 9 Feedyard 10 Livestock pens 11 Fuel storage 12 Fertilizer storage 13 Insecticide storage 14 Abandoned water well 15 Oil well/Gas well 16 Other (specify below) FIELD
irection from well? All How many feet?

FROM	TO	LITHOLOGIC LOG	FROM	TO	LITHOLOGIC LOG
0	12	Fine sand, topsoil & sandy brown clay			
12	26	Sand & gravel, medium to coarse			
26	45	Sandy brown clay			
45	53	Gray & black clay			
53	66	Sand & gravel, medium to fine - Clean			
66	93	Brown sandy clay			
93	129	Sand & gravel, fine, clean			

CONTRACTOR'S OR LANDOWNER'S CERTIFICATION: This water well was (1) constructed, (2) reconstructed, or (3) plugged under my jurisdiction and was mpleted on (mo/day/year) 3-1-82 and this record is true to the best of my knowledge and belief. Kansas ater Well Contractor's License No. 185 This Water Well Record was completed on (mo/day/yr) 3-3-82
der the business name of Clarke Well & Eq., Inc. by (signature) [signature]

STRUCTIONS: Use typewriter or ball point pen, *PLEASE PRESS FIRMLY* and *PRINT* clearly. Please fill in blanks, underline or circle the correct answers. Send top ee copies to Kansas Department of Health and Environment, Division of Environment, Environmental Geology Section, Topeka, KS 66620. Send one to WATER WELL WNER and retain one for your records.

OFFICE USE ONLY T 20 R 14 (W) SEC. 28 CSW ¼ ¼ ¼