

1	LOCATION OF WATER WELL:	Fraction	Section Number	Township Number	Range Number
County: Barton	SW ¼ NE ¼ SW ¼	14	T 20 S	R 14 E/W	

Distance and direction from nearest town or city street address of well if located within city?

3½ South, 1½ West of XX Great Bend

2	WATER WELL OWNER: F G Holl
---	----------------------------

Richard Brocher~~K~~

WW060414

RR#, St. Address, Box # : P.O. Box 780167
City, State, ZIP Code : Wichita, Ks. 67278

RR1- Box 171
Great Bend, Ks. 67530


Board of Agriculture, Division of Water Resources
Application Number: 20060141

3 LOCATE WELL'S LOCATION WITH

4 DEPTH OF COMPLETED WELL 60' ft. ELEVATION:

AN "X" IN SECTION BOX:

N

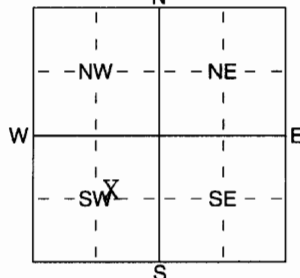

Depth(s) Groundwater Encountered 1 ft. 2 ft. 3 ft.

WELL'S STATIC WATER LEVEL 12 ft. below land surface measured on mo/day/yr 4-19-06

Pump test data:	Well water was	ft. after	hours pumping	gpm
Est. Yield XX N/A gpm:	Well water was	ft. after	hours pumping	gpm

WELL WATER TO BE USED AS:

1 Domestic	3 Feedlot	5 Public water supply	8 Air conditioning	11 Injection well
2 Irrigation	4 Industrial	6 <u>Oil field water supply</u>	9 Dewatering	12 Other (Specify below)
		7 Domestic (lawn & garden)	10 Monitoring well	

Was a chemical/bacteriological sample submitted to Department? Yes No ^X; If yes, mo/day/yr sample was submitted

Water Well Disinfected? Yes HTH No

5	TYPE OF BLANK CASING USED:
---	----------------------------

5 Wrought iron

8 Concrete tile

CASING JOINTS: GluedX Clamped

1 Steel	3 RMP (SR)
2 PVC	4 ABS

6 Asbestos-Cement
7 Fiberglass

9 Other (specify below)

Welded

Threaded

Blank casing diameter 5 in. to 40 ft. Dia _____ in. to _____ ft. Dia _____ in. to _____ ft.

Casing height above land surface 24 in., weight SDR-26 lbs./ft. Wall thickness or gauge No.

TYPE OF SCREEN OR PERFORATION MATERIAL:

1 Steel	3 Stainless Steel	5 Fiberglass	8 RMP (SR)	11 Other (Specify)
2 Brass	4 Galvanized Steel	6 Concrete tile	9 ABS	12 None used (open hole)

SCREEN OR PERFORATION OPENINGS ARE:

1 Continuous slot	3 Mill slot	6 Wire wrapped	9 Drilled holes
2 Louvered shutter	4 Key punched	7 Torch cut	10 Other (specify) _____ ft.

SCREEN-PERFORATED INTERVALS: From 60 ft. to 40 ft., From _____ ft. to _____ ft.

GRAVEL PACK INTERVALS:

6	GROUT MATERIAL:
---	-----------------

1 Neat cement

2 Cement grout

3 Bentonite

4 Other.....hole plug

Grout Intervals: From ft. to ft., From ft. to ft., From 20 ft. to 0 ft.

What is the nearest source of possible contamination:

1 Septic tank	4 Lateral lines	7 Pit privy	10 Fuel storage	15 Oil well/Gas well
2 Sewer lines	5 Cess pool	8 Sewage lagoon	12 Fertilizer storage	16 Other (specify below)
3 Watertight sewer lines	6 Seepage pit	9 Feedyard	13 Insecticide storage	None.....

Direction from well?

How many feet?

[illegible]

7 CONTRACTOR'S OR LANDOWNER'S CERTIFICATION: This water well was (1) constructed, (2) reconstructed, or (3) plugged under my jurisdiction and was completed on (mo/day/year) 4-19-06 and this record is true to the best of my knowledge and belief. Kansas Water Well Contractor's Licence No 134 This Water Well Record was completed on (mo/day/yr) 4-21-06 under the business name of Rosencrantz- Bemis by (signature) [Signature] 301