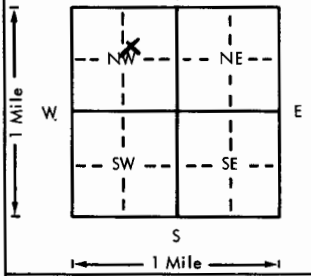


USE TYPEWRITER OR BALL
POINT PEN-PRESS FIRMLY,
PRINT CLEARLY.

WATER WELL RECORD
KSA 82a-1201-1215

Kansas Department of Health and
Environment-Division of Environment
(Water well Contractors)
Topeka, Kansas 66620

Woodburn #1

Location of well: <i>Barton</i>	County: <i>Barton</i>	Fraction: <i>SW 1/4 NE 1/4 NW 1/4</i>	Section number: <i>34</i>	Township number: <i>20 S</i>	Range number: <i>14 W</i>
2. Distance and direction from nearest town or city: <i>6 south</i>		3. Owner of well: <i>C. & S. Drilling Co</i>			
Street address of well location if in city: <i>5 west St Bend Ks</i>		R.R. or street: <i>Plainville Kansas</i>			
City, state, zip code: <i>Plainville Kansas</i>					
4. Locate with "X" in section below:		Sketch map:		6. Bore hole dia. <i>7</i> in. Completion date <i>7-1-77</i>	
				Well depth <i>70</i> ft.	
5. Type and color of material		From To		7. Cable tool ☒ Rotary ☐ Driven ☐ Dug	
<i>Sandy Clay</i>		<i>0 25</i>		☐ Hollow rod ☐ Jetted ☐ Bored ☐ Reverse rotary	
<i>Sand</i>		<i>25 50</i>		8. Use: ☐ Domestic ☐ Public supply ☐ Industry	
<i>Gravel</i>		<i>50 70</i>		☐ Irrigation ☐ Air conditioning ☐ Stock	
				☐ Lawn ☒ Oil field water ☐ Other	
				9. Casing: Material <i>Plastic</i> Height: <i>Above</i> or below	
				Threaded ☐ Welded ☒ Surface <i>12</i> in.	
				RMP ☐ PVC ☒ Weight <i>178.3</i> lbs./ft.	
				Dia. <i>7</i> in. to <i>70</i> ft. depth Wall thickness: inches or	
				Dia. <i>7</i> in. to <i>70</i> ft. depth gage No. <i>Scudal 40</i>	
				10. Screen Manufacturer's name <i>Self made</i>	
				Type <i>PVC</i> Dia. <i>4</i>	
				Slot/gauze <i>5</i> Length <i>20</i>	
				Set between <i>50</i> ft. and <i>70</i> ft.	
				Gravel pack? <i>yes</i> size range of material <i>5-1/4</i>	
				11. Static water level: <i>14</i> ft. below land surface Date <i>2-7-77</i>	
				mg./day/yr.	
				12. Pumping level below land surfaces:	
				____ ft. after ____ hrs. pumping ____ g.p.m.	
				____ ft. after ____ hrs. pumping ____ g.p.m.	
				Estimated maximum yield ____ g.p.m.	
				13. Water sample submitted: ____ mo./day/yr.	
				Yes ☒ No ☐ Date ____	
				14. Well head completion:	
				____ Pitless adapter ____ inches above grade	
				15. Well grouted? <i>yes</i>	
				With: ____ Neat cement ☒ Bentonite ____ Concrete	
				Depth: From <i>0</i> ft. to <i>10</i> ft.	
				16. Nearest source of possible contamination:	
				ft. ____ Direction ____ Type ____	
				Well disinfected upon completion? ____ Yes ____ No	
				17. Pump: ☒ Not installed	
				Manufacturer's name ____	
				Model number ____ HP ____ Volts ____	
				Length of drop pipe ____ ft. capacity ____ g.p.m.	
				Type:	
				____ Submersible ____ Turbine	
				____ Jet ____ Reciprocating	
				____ Centrifugal ____ Other	
18. Elevation:		19. Remarks:		20. Water well contractor's certification:	
Topography:				This well was drilled under my jurisdiction and this report	
☐ Hill				is true to the best of my knowledge and belief.	
☒ Slope				<i>Myers Water Well</i>	
☐ Upland				Business name <i>Myers</i> License No. <i>143</i>	
☐ Valley				Address <i>St Bend Ks</i>	
				Sign <i>Myers</i> Date <i>7-1-77</i>	
				Authorized representative	

Forward the white, blue and pink copies to the Department of Health and Environment

Form WWC-5