

WATER WELL RECORD Form WWC-5

Division of Water Resources App. No.


[Empty box]

Well ID OBI-18 North

Original Record Correction Change in Well Use

1 LOCATION OF WATER WELL: County: Barton Fraction NW 1/4 NW 1/4 SW 1/4 NE 1/4 Section Number 20 Township Number T 20 S Range Number R 14 E W

2 WELL OWNER: Last Name: First: Street or Rural Address where well is located (if unknown, distance and direction from nearest town or intersection):

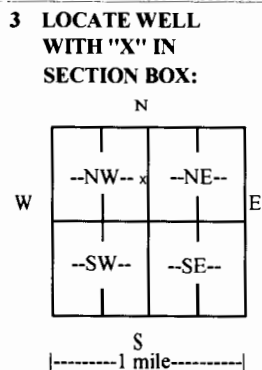

4 DEPTH OF COMPLETED WELL: 30 ft. Depth(s) Groundwater Encountered: 1) ft. 2) ft. 3) ft., or 4) Dry Well WELL'S STATIC WATER LEVEL: 9 ft.

5 Latitude: 38.299581 (decimal degrees) Longitude: -98.893757 (decimal degrees) Horizontal Datum: WGS 84 NAD 83 NAD 27

7 WELL WATER TO BE USED AS: 1. Domestic: Household Lawn & Garden Livestock Irrigation Feedlot Industrial 5. Public Water Supply: well ID 6. Dewatering: how many wells? 7. Aquifer Recharge: well ID 8. Monitoring: well ID 9. Environmental Remediation: well ID

Was a chemical/bacteriological sample submitted to KDHE? Yes No If yes, date sample was submitted: Water well disinfected? Yes No

8 TYPE OF CASING USED: Steel PVC CASING JOINTS: Glued Clamped Welded Threaded Other Casing diameter 2 in. to 8 ft., Diameter in. to ft., Diameter in. to ft. Casing height above land surface 24 in. Weight .73 lbs./ft. Wall thickness or gauge No. .214

9 GROUT MATERIAL: Neat cement Cement grout Bentonite Other Grout Intervals: From 0 ft. to 7 ft., From ft. to ft., From ft. to ft.

Nearest source of possible contamination: Septic Tank Lateral Lines Pit Privy Livestock Pens Insecticide Storage Sewer Lines Cess Pool Sewage Lagoon Fuel Storage Abandoned Water Well Watertight Sewer Lines Seepage Pit Feedyard Fertilizer Storage Oil Well/Gas Well

Table with columns: FROM, TO, LITHOLOGIC LOG, FROM, TO, LITHO. LOG (cont.) or PLUGGING INTERVALS. Rows show depth intervals and lithology: 0-4 Topsoil, 4-6 Clay, gray, 6-27 Sand & gravel, medium to fine, 27-28 Clay, tan, 28-35 Sand & gravel, medium to fine.

Notes: Grout depth modified to meet local conditions.

11 CONTRACTOR'S OR LANDOWNER'S CERTIFICATION: This water well was constructed, reconstructed, or plugged under my jurisdiction and was completed on (mo-day-year) 04-25-18 and this record is true to the best of my knowledge and belief.