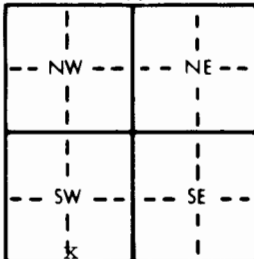
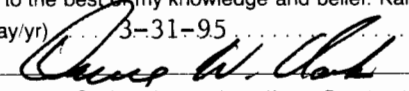


1 LOCATION OF WATER WELL:		Fraction SOUTH <u>1/2</u>	Section Number 6	Township Number T 20 S	Range Number R 14 W
County: Barton NC 1/4 SW SW 1/4					
Distance and direction from nearest town or city street address of well if located within city? Approximately 2 miles north and 1 1/4 miles west of Dundee					
2 WATER WELL OWNER:		Eldon Dirks			
RR#, St. Address, Box # :		Route 1 - Box 153		Board of Agriculture, Division of Water Resources	
City, State, ZIP Code :		Great Bend, KS 67530		Application Number: 8791	
3 LOCATE WELL'S LOCATION WITH AN "X" IN SECTION BOX:		4 DEPTH OF COMPLETED WELL: 84 ft. ELEVATION: unknown			
		Depth(s) Groundwater Encountered 1. ft. 2. ft. 3. ft.			
		WELL'S STATIC WATER LEVEL 30 ft. below land surface measured on mo/day/yr 3-24-95			
		Pump test data: Well water was not ch'd. ft. after hours pumping gpm			
		Est. Yield unknown gpm: Well water was ft. after hours pumping gpm			
		Bore Hole Diameter 24 in. to 83 ft., and in. to ft.			
		WELL WATER TO BE USED AS:			
		5 Public water supply 8 Air conditioning 11 Injection well			
		1 Domestic 3 Feedlot 6 Oil field water supply 9 Dewatering 12 Other (Specify below)			
		2 Irrigation 4 Industrial 7 Lawn and garden only 10 Monitoring well			
		Was a chemical/bacteriological sample submitted to Department? Yes No X; If yes, mo/day/yr sample was submitted			
		Water Well Disinfected? Yes No X			
5 TYPE OF BLANK CASING USED:		CASING JOINTS: Glued Clamped			
1 Steel 3 RMP (SR)		5 Wrought iron 8 Concrete tile			
2 PVC 4 ABS		6 Asbestos-Cement 9 Other (specify below)			
7 Fiberglass		Welded X			
Blank casing diameter 16 in. to 43 ft., Dia		Threaded			
Casing height above land surface 12 in., weight 36, 87 lbs./ft. Wall thickness or gauge No. 219					
TYPE OF SCREEN OR PERFORATION MATERIAL:		7 PVC 10 Asbestos-cement			
1 Steel 3 Stainless steel 5 Fiberglass 8 RMP (SR) 11 Other (specify)					
2 Brass 4 Galvanized steel 6 Concrete tile 9 ABS 12 None used (open hole)					
SCREEN OR PERFORATION OPENINGS ARE:		5 Gauzed wrapped 8 Saw cut 11 None (open hole)			
1 Continuous slot 3 Mill slot 6 Wire wrapped 9 Drilled holes					
2 Louvered shutter 4 Key punched 7 Torch cut 10 Other (specify) Bridge Slot					
SCREEN-PERFORATED INTERVALS:		From 43 ft. to 83 ft. From ft. to ft.			
GRAVEL PACK INTERVALS:		From 21 ft. to 83 ft. From ft. to ft.			
6 GROUT MATERIAL:		2 Cement grout 3 Bentonite 4 Other			
Grout Intervals: From 0 ft. to 21 ft. From ft. to ft. From ft. to ft.					
What is the nearest source of possible contamination:		10 Livestock pens 14 Abandoned water well			
1 Septic tank 4 Lateral lines 7 Pit privy 11 Fuel storage 15 Oil well/Gas well					
2 Sewer lines 5 Cess pool 8 Sewage lagoon 12 Fertilizer storage 16 Other (specify below)					
3 Watertight sewer lines 6 Seepage pit 9 Feedyard 13 Insecticide storage None known					
Direction from well?		How many feet?			
FROM	TO	LITHOLOGIC LOG	FROM	TO	PLUGGING INTERVALS
0	4	Topsoil			
4	7	Clay			
7	9	Sand and gravel, medium, coarse			
9	15	Clay, brown			
15	50	Sand and gravel, medium, coarse, clay streak at 48'			
50	57	Sand and gravel, fine, medium			
57	58	Clay			
58	68	Sand and gravel, very fine, mixed with clay			
68	80	Clay with gravel streaks			
80	83	Sand and gravel, very fine, fine			
7 CONTRACTOR'S OR LANDOWNER'S CERTIFICATION: This water well was (1) constructed, (2) reconstructed, or (3) plugged under my jurisdiction and was completed on (mo/day/year) 3-24-95 and this record is true to the best of my knowledge and belief. Kansas Water Well Contractor's License No. 185 This Water Well Record was completed on (mo/day/yr) 3-31-95 under the business name of Clarke Well & Equipment, Inc. by (signature) 					
INSTRUCTIONS: Use typewriter or ball point pen. PLEASE PRESS FIRMLY and PRINT clearly. Please fill in blanks, underline or circle the correct answers. Send top three copies to Kansas Department of Health and Environment, Bureau of Water, Topeka, Kansas 66620-0001. Telephone: 913-296-5545. Send one to WATER WELL OWNER and retain one for your records.					