


1. LOCATION OF WATER WELL:	Fraction	Section Number	Township Number	Range Number
County: Barton	NE ¼ NE ¼ NE ¼	16	T 20 S	R 15 EW

Distance and direction from nearest town or city street address of well if located within city?

Approx. 3 $\frac{1}{2}$ Miles North of Pawnee Rock, KS

2	WATER WELL OWNER:	Bergthal Mennonite Church	
	RR#, St. Address, Box # :	Route 1 - Box 27	Board of Agriculture, Division of Water Resources
	City, State, ZIP Code :	Pawnee Rock, KS 67567	Application Number: N/A

3	LOCATE WELL'S LOCATION WITH AN "X" IN SECTION BOX:	4	DEPTH OF COMPLETED WELL... 112 ft. ELEVATION: unknown
---	--	---	---

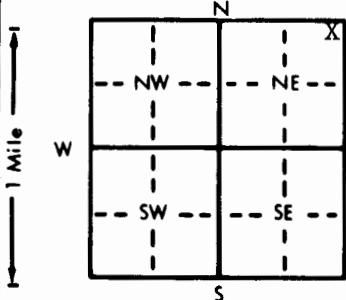

4 DEPTH OF COMPLETED WELL... 112 ft. ELEVATION: unknown
 Depth(s) Groundwater Encountered 1. 57 ft. 2. ft. 3. ft.
 WELL'S STATIC WATER LEVEL .. 57 ft. below land surface measured on mo/day/yr .. 11/16/87
 Pump test data: Well water was Not Ck'd. ft. after hours pumping gpm
 Est. Yield Unknown gpm: Well water was ft. after hours pumping gpm
 Bore Hole Diameter... 11 in. to ... 110 ft., and in. to ft.
 WELL WATER TO BE USED AS: 5 Public water supply 8 Air conditioning 11 Injection well
 1 Domestic 3 Feedlot 6 Oil field water supply 9 Dewatering 12 Other (Specify below)
 2 Irrigation 4 Industrial 7 Lawn and garden only 10 Observation well
 Was a chemical/bacteriological sample submitted to Department? Yes.....No. ☒.....; If yes, mo/day/yr sample was submitted
 Water Well Disinfected? Yes ☒ No

5 TYPE OF BLANK CASING USED:		5 Wrought iron	8 Concrete tile	CASING JOINTS: <u>Glued</u> ☒ <u>Clamped</u> ☐
1 Steel	3 RMP (SR)	6 Asbestos-Cement	9 Other (specify below)	<u>Welded</u> ☐
<u>2 PVC</u>	4 ABS	7 Fiberglass		<u>Threaded</u> ☐
Blank casing diameter . . . 5 . . . in. to . . . 7.5 . . . ft., Dia . . . 5 . . . in. to . . . 9.5 . . . ft., Dia . . . in. to . . . ft.				
Casing height above land surface . . . 24 . . . in., weight . . . 2,277 . . . lbs./ft. Wall thickness or gauge No. . . . 214				

TYPE OF SCREEN OR PERFORATION MATERIAL:			<u>7 PVC</u>	10 Asbestos-cement
1 Steel	3 Stainless steel	5 Fiberglass	8 RMP (SR)	11 Other (specify)
2 Brass	4 Galvanized steel	6 Concrete tile	9 ABS	12 None used (open hole)
SCREEN OR PERFORATION OPENINGS ARE:			5 Gauzed wrapped	8 Saw cut
1 Continuous slot	3 Mill slot	6 Wire wrapped	<u>9 Drilled holes</u>	11 None (open hole)
2 Louvered shutter	4 Key punched	7 Torch cut	<u>10 Other (specify)</u>	

SCREEN-PERFORATED INTERVALS:	From 75 ft. to 85 ft., From ft. to ft.
	From 95 ft. to 110 ft., From ft. to ft.
GRAVEL PACK INTERVALS:	From 92 ft. to 110 ft., From ft. to ft.
	From 70 ft. to 90 ft. From Annular Fill 20 ft to XXX 67 ft.

6 GROUT MATERIAL: a) Neat cement 2 Cement grout b) 3 Bentonite 4 Other
Grout Intervals: From a) 5 ft. to 20 ft. From b) 90 ft. to 92 ft. From b) 67 ft. to 70 ft.

What is the nearest source of possible contamination:

1 Septic tank	4 Lateral lines	7 Pit privy	11 Fuel storage	15 Oil well/Gas well
2 Sewer lines	5 Cess pool	8 Sewage lagoon	12 Fertilizer storage	16 Other (specify below)
3 Watertight sewer lines	6 Seepage pit	9 Feedyard	13 Insecticide storage	

Direction from well? northeast

How many feet? 102'

[illegible]

7 CONTRACTOR'S OR LANDOWNER'S CERTIFICATION: This water well was (1) constructed, (2) reconstructed, or (3) plugged under my jurisdiction and was completed on (mo/day/year) 11/16/87 and this record is true to the best of my knowledge and belief. Kansas Water Well Contractor's License No. 185 This Water Well Record was completed on (mo/day/yr) 11/17/87 under the business name of Clarke Well & Equipment, Inc. by (signature) [Signature]

INSTRUCTIONS: Use typewriter or ball point pen. PLEASE PRESS FIRMLY and PRINT clearly. Please fill in blanks, underline or circle the correct answers. Send top three copies to Kansas Department of Health and Environment, Office of Oil Field and Environmental Geology, Regulation and Permitting Section, Topeka, Kansas 66620-7500, Telephone: 913-862-9360. Send one to WATER WELL OWNER and retain one for your records.