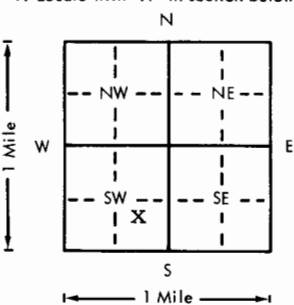


USE TYPEWRITER OR BALL
POINT PEN-PRESS FIRMLY,
PRINT CLEARLY.

WATER WELL RECORD
KSA 82a-1201-1215

Kansas Department of Health and
Environment-Division of Environment
(Water well Contractors)
Topeka, Kansas 66620

1. Location of well:		County Barton	Fraction NW 1/4 SE 1/4 SW 1/4	Section number 23	Township number T 20 S R 15 E W	Range number 15
2. Distance and direction from nearest town or city: 3 miles Northeast of Pawnee Rock, KS Street address of well location if in city:				3. Owner of well: Loren Unruh R.R. or street: 2401 Dove City, state, zip code: Great Bend, KS 67530		
4. Locate with "X" in section below:		Sketch map:		6. Bore hole dia. 24 in. Completion date 6-8-77 Well depth 52 ft.		
				7. ☐ Cable tool ☐ Rotary ☐ Driven ☐ Dug ☐ Hollow rod ☐ Jetted ☐ Bored ☒ Reverse rotary		
5. Type and color of material		From	To	8. Use: ☐ Domestic ☐ Public supply ☐ Industry ☒ Irrigation ☐ Air conditioning ☐ Stock ☐ Lawn ☐ Oil field water ☐ Other		
Top soil		0	3	9. Casing: Material steel Height: Above or below Threaded ☐ Welded ☒ Surface 12 in. RMP ☐ PVC ☐ Weight 3.03 lbs./ft. Dia. 16 in. to 25 ft. depth Wall Thickness: inches or Dia. ☐ in. to ☐ ft. depth gage No. 7 ga.		
Brown & gray clay		3	17	10. Screen: Manufacturer's name D-Doerr C-Cook Type Double-slot Dia. 16" Slot/gauze 1/8 Length D-17' & C- 10' Set between D-25-29 ft. and 39-52 ft. C-29 ft. and 39 ft. Gravel pack? yes Size range of material 3/8-200		
Sand & gravel & xx clay streak at 32'		17	38	11. Static water level: ☐ mo./day/yr. 21 ft. below land surface Date 2-21-77		
Brown clay & thin gravel streaks		38	51	12. Pumping level below land surfaces: N/C ____ ft. after ____ hrs. pumping ____ g.p.m. ____ ft. after ____ hrs. pumping ____ g.p.m. Estimated maximum yield ____ g.p.m.		
Dakota clay		51	52	13. Water sample submitted: ____ mo./day/yr. Yes ☒ No ☐ Date ____		
				14. Well head completion: ____ Pitless adapter ____ 12 inches above grade		
				15. Well grouted? yes With: ☒ Neat cement ____ Bentonite ____ Concrete ____ Depth: From 0 ft. to 10 ft.		
				16. Nearest source of possible contamination: FIELD ft. ____ Direction ____ Type ____ Well disinfected upon completion? ____ Yes ☒ No ☐		
				17. Pump: ____ Not installed Manufacturer's name Berkeley Pump Co. Model number 6S2AM-6 HP 20 Volts 460 Length of drop pipe 30 ft. capacity 270 g.p.m. Type: ☒ Submersible ____ Turbine ____ Jet ____ Reciprocating ____ Centrifugal ____ Other		
				(Use a second sheet if needed)		
18. Elevation: 1133 Topography: ____ Hill ____ Slope ____ Upland ____ Valley		19. Remarks: 1133		20. Water well contractor's certification: This well was drilled under my jurisdiction and this report is true to the best of my knowledge and belief. Clarke Well & Eq., Inc. 185 Business name Address Great Bend, KS 67530 License No. ____ Signed [Signature] Date 6-9-77 Authorized representative		

Forward the white, blue and pink copies to the Department of Health and Environment

Form WWC-5